


ALLOTMENT 319 in DEV. NO. 145/D135/12
in the area named
SEAFORD HEIGHTS
CT 6186/97

KINTORE ROAD


AS-CONSTRUCTED

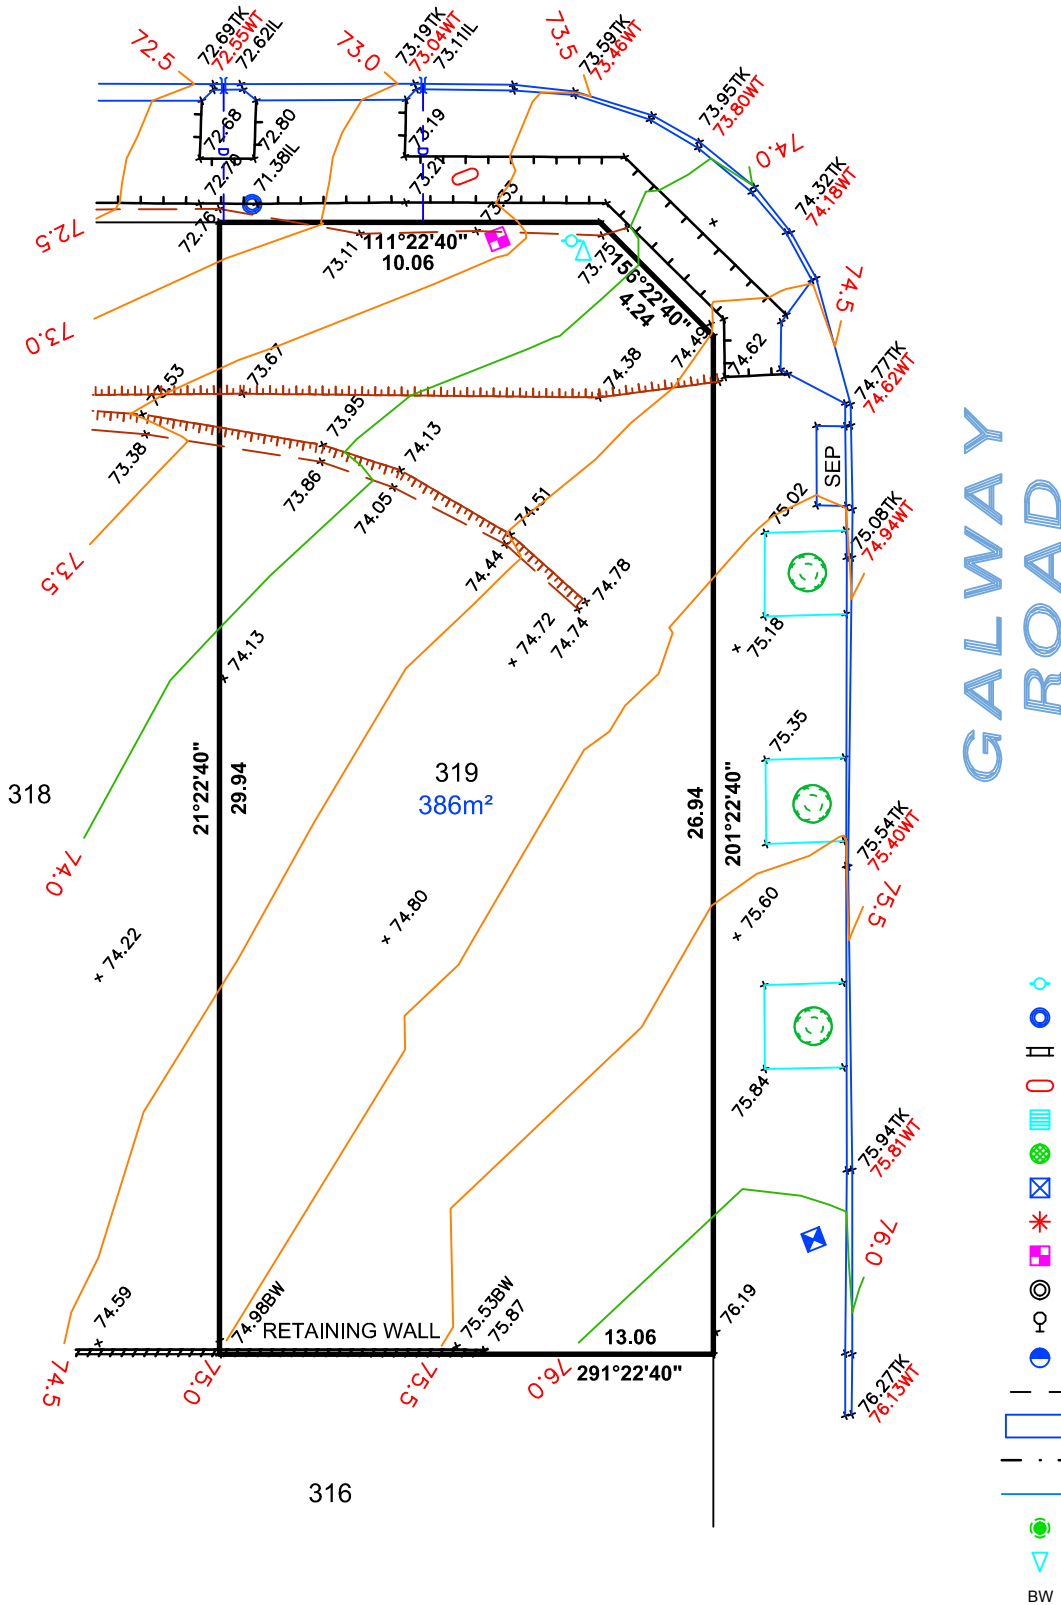

IMPORTANT
 SERVICE AND DRIVEWAY LOCATIONS
 ARE APPROXIMATE. ANY CHANGES WILL
 BE AT THE PURCHASERS EXPENSE.
 PURCHASER: _____
 PURCHASER: _____
 DATE: _____

ALLOTMENT 135 in DEV. NO. 145/D135/12
 in the area named
SEAFORD HEIGHTS
 CT ---/----

AS CONSTRUCTED

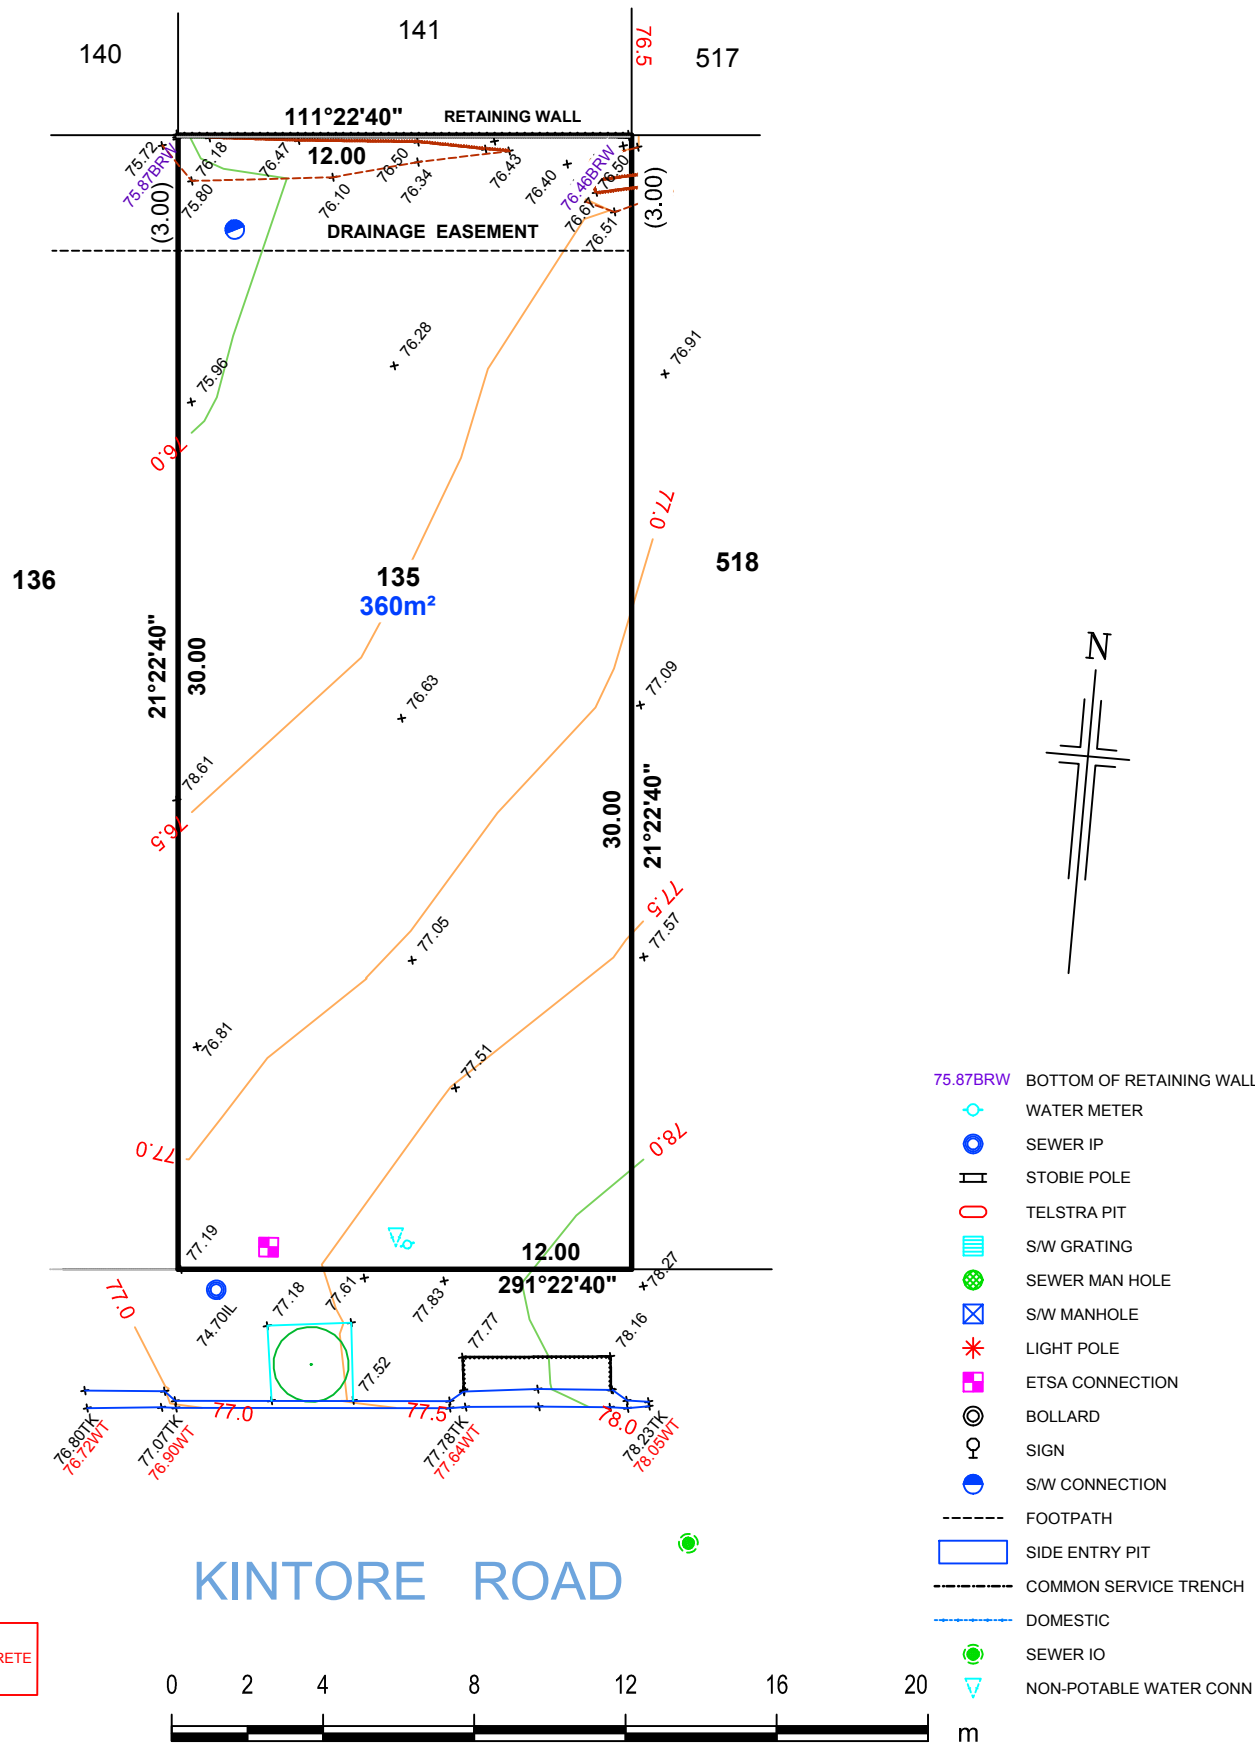

NOTE:
 DRIVEWAY IN CONCRETE
 BY DEVELOPER