


ALLOTMENT 472 in DEV. NO. 145/D215/12/007

in the area named  
**SEAFORD HEIGHTS**

CT ---/----

**AS CONSTRUCTED**

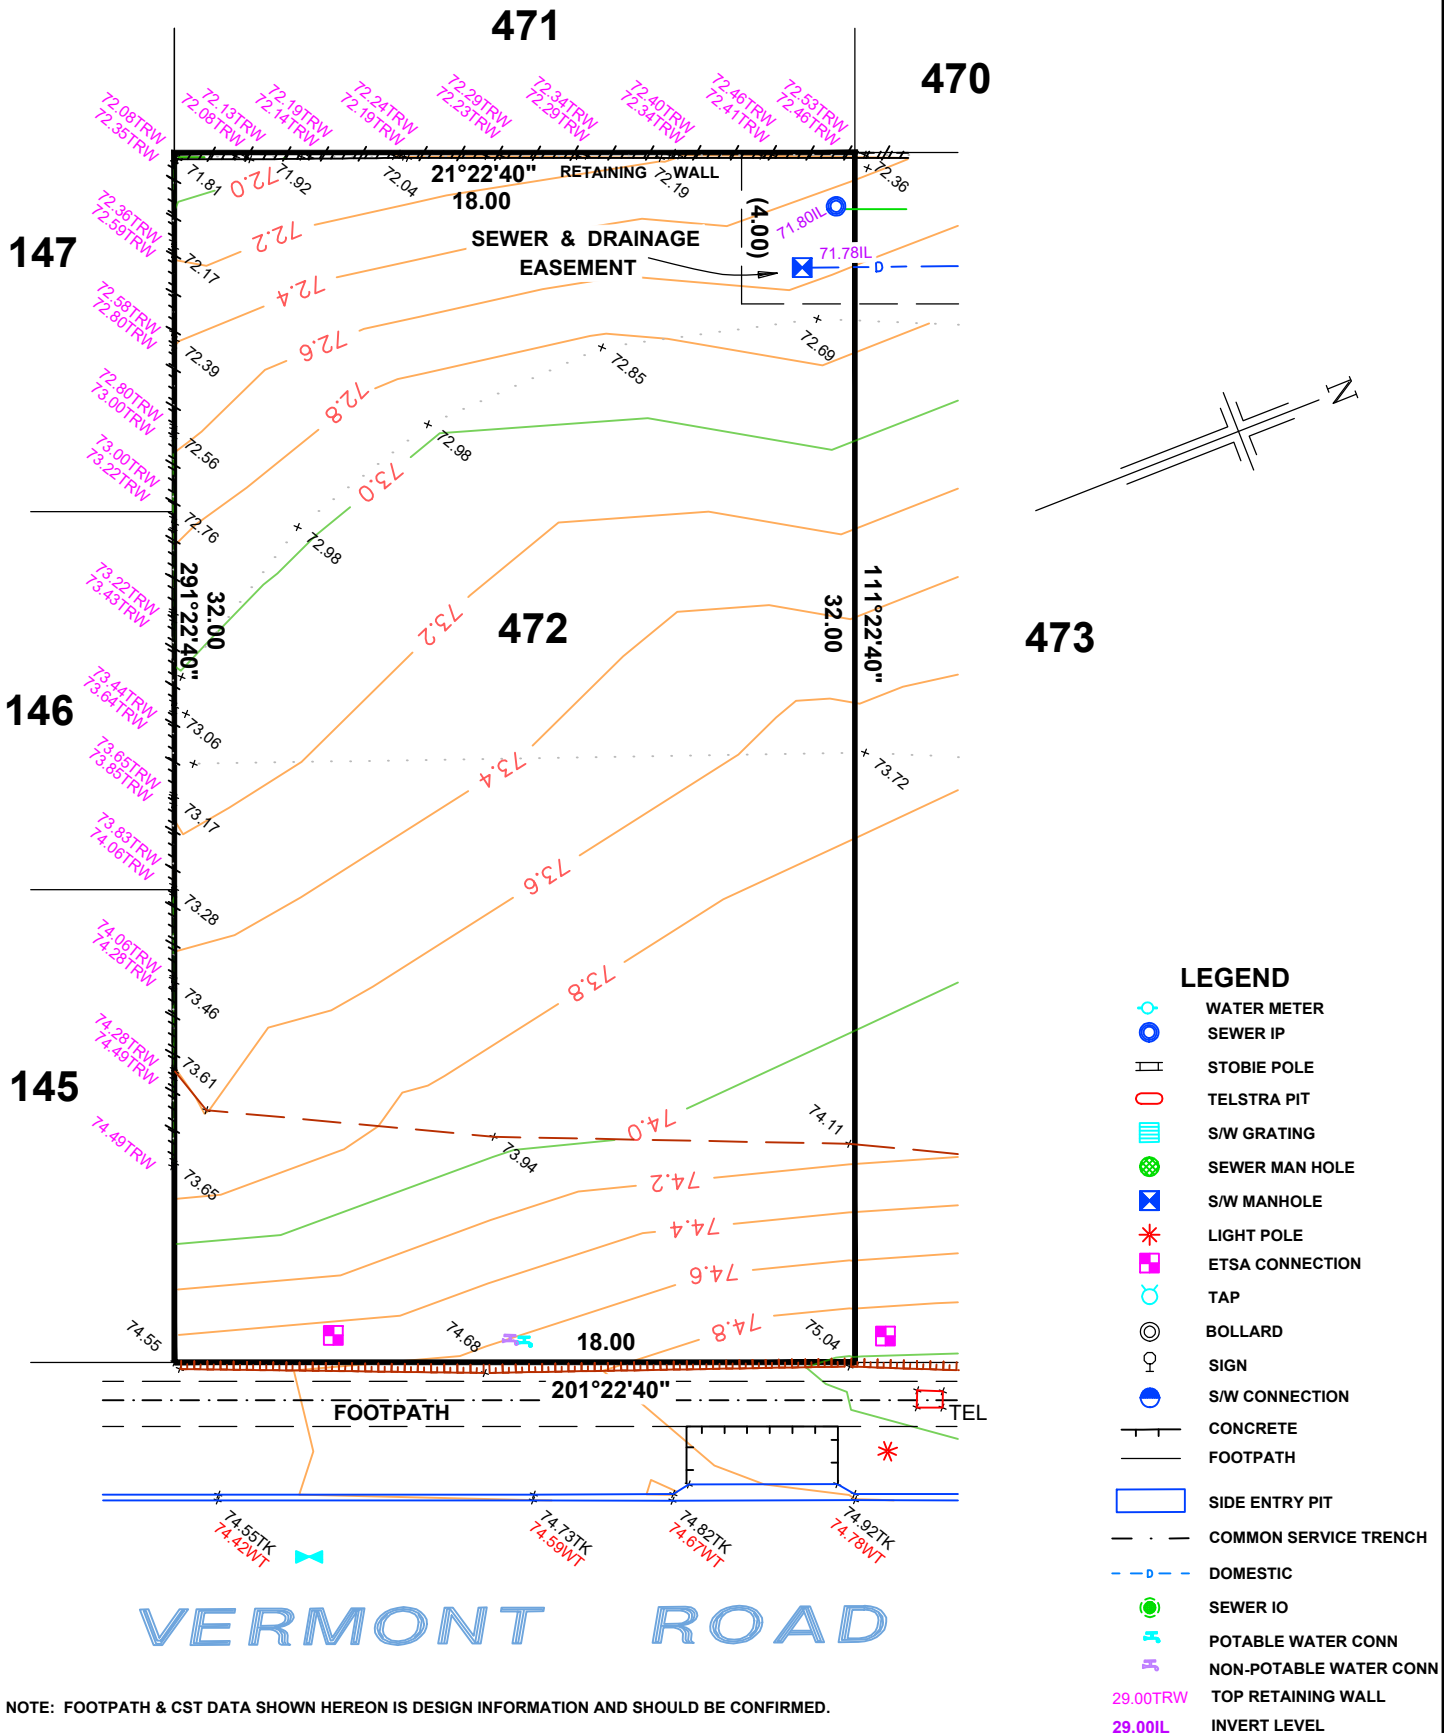

**LEGEND**

- WATER METER
- SEWER IP
- STOBIE POLE
- TELSTRA PIT
- S/W GRATING
- SEWER MAN HOLE
- S/W MANHOLE
- LIGHT POLE
- ETSA CONNECTION
- TAP
- BOLLARD
- SIGN
- S/W CONNECTION
- CONCRETE
- FOOTPATH
- SIDE ENTRY PIT
- COMMON SERVICE TRENCH
- DOMESTIC
- SEWER IO
- POTABLE WATER CONN
- NON-POTABLE WATER CONN
- 29.00TRW TOP RETAINING WALL
- 29.00IL INVERT LEVEL

NOTE: FOOTPATH & CST DATA SHOWN HEREON IS DESIGN INFORMATION AND SHOULD BE CONFIRMED.



ALEXANDER SYMONDS  
PH 8130 1666

1:200



ORIGINAL SHEET SIZE A4

ALLOTMENT 473 in DEV. NO. 145/D215/12/007

in the area named  
**SEAFORD HEIGHTS**

CT ---/----

**AS CONSTRUCTED**

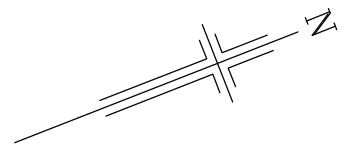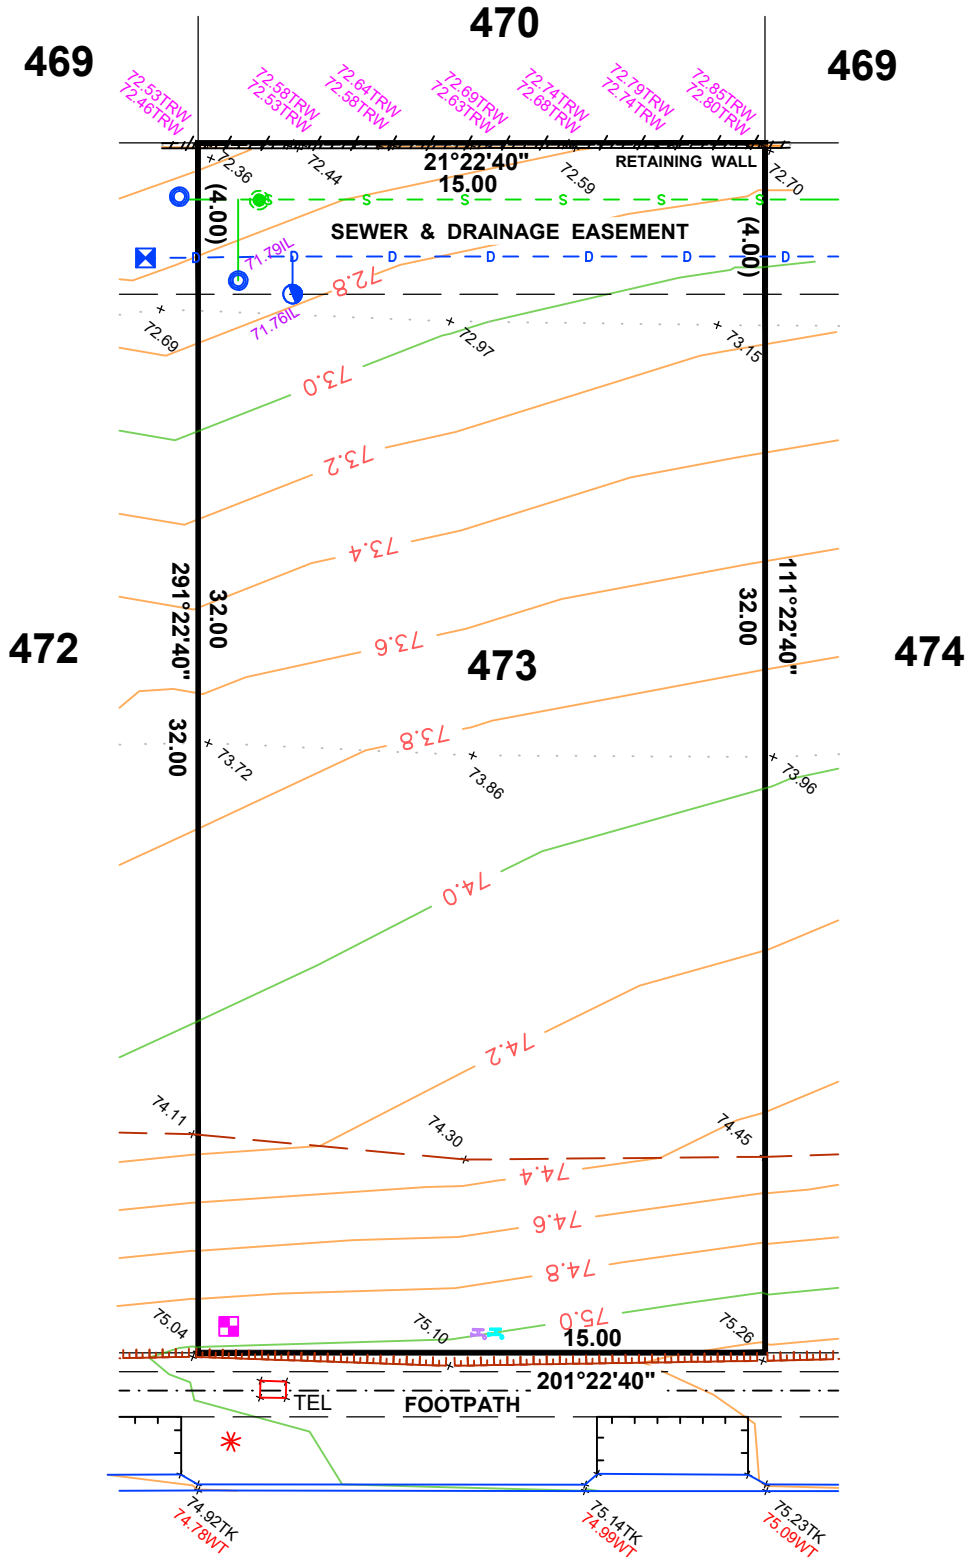

**LEGEND**

- WATER METER
- SEWER IP
- STOBIE POLE
- TELSTRA PIT
- S/W GRATING
- SEWER MAN HOLE
- S/W MANHOLE
- LIGHT POLE
- ETSA CONNECTION
- TAP
- BOLLARD
- SIGN
- S/W CONNECTION
- CONCRETE
- FOOTPATH
- SIDE ENTRY PIT
- COMMON SERVICE TRENCH
- DOMESTIC
- SEWER IO
- POTABLE WATER CONN
- NON-POTABLE WATER CONN
- 29.00TRW TOP RETAINING WALL
- 29.00IL INVERT LEVEL

**VERMONT ROAD**

NOTE: FOOTPATH & CST DATA SHOWN HEREON IS DESIGN INFORMATION AND SHOULD BE CONFIRMED.



ALEXANDER SYMONDS  
PH 8130 1666

1:200



ORIGINAL SHEET SIZE A4

ALLOTMENT 474 in DEV. NO. 145/D215/12/007

in the area named  
**SEAFORD HEIGHTS**

CT ---/----

**AS CONSTRUCTED**

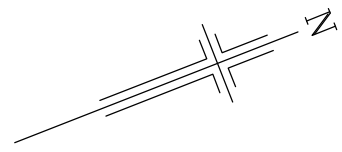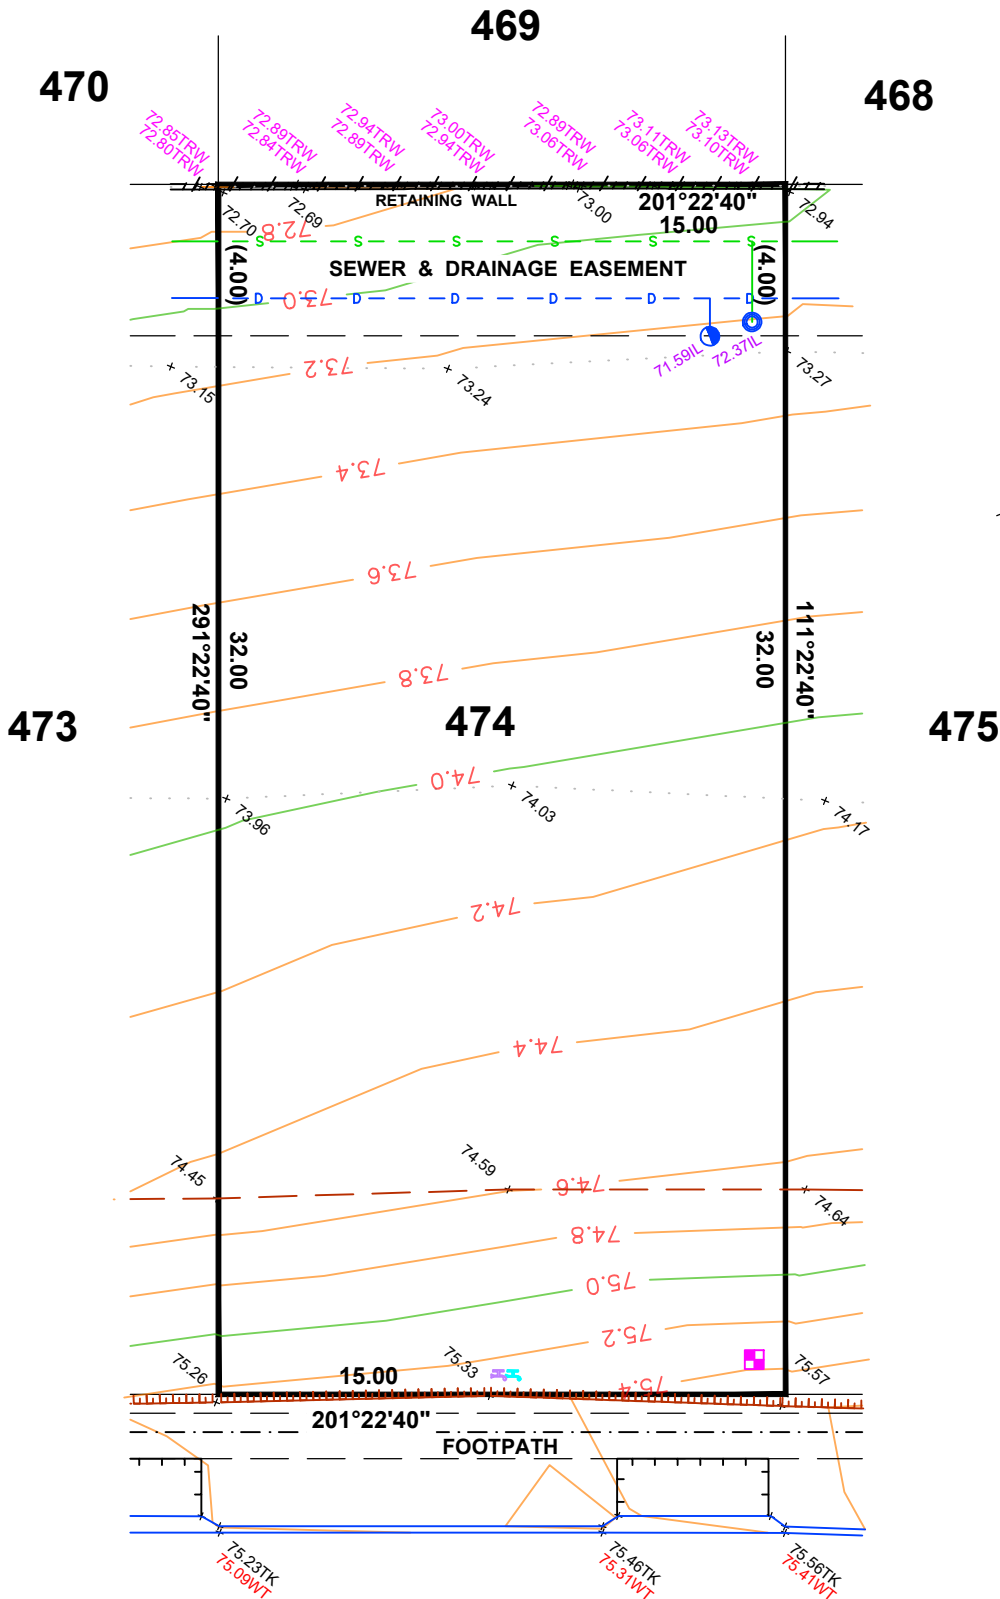

**LEGEND**

- WATER METER
- SEWER IP
- STOBIE POLE
- TELSTRA PIT
- S/W GRATING
- SEWER MAN HOLE
- S/W MANHOLE
- LIGHT POLE
- ETSA CONNECTION
- TAP
- BOLLARD
- SIGN
- S/W CONNECTION
- CONCRETE
- FOOTPATH
- SIDE ENTRY PIT
- COMMON SERVICE TRENCH
- DOMESTIC
- SEWER IO
- POTABLE WATER CONN
- NON-POTABLE WATER CONN
- 29.00TRW TOP RETAINING WALL
- 29.00IL INVERT LEVEL

NOTE: FOOTPATH & CST DATA SHOWN HEREON IS DESIGN INFORMATION AND SHOULD BE CONFIRMED.



1:200

ALEXANDER SYMONDS  
PH 8130 1666

ORIGINAL SHEET SIZE A4

ALLOTMENT 475 in DEV. NO. 145/D215/12/007

in the area named  
**SEAFORD HEIGHTS**


CT ---/----

**AS CONSTRUCTED**

469

468

467

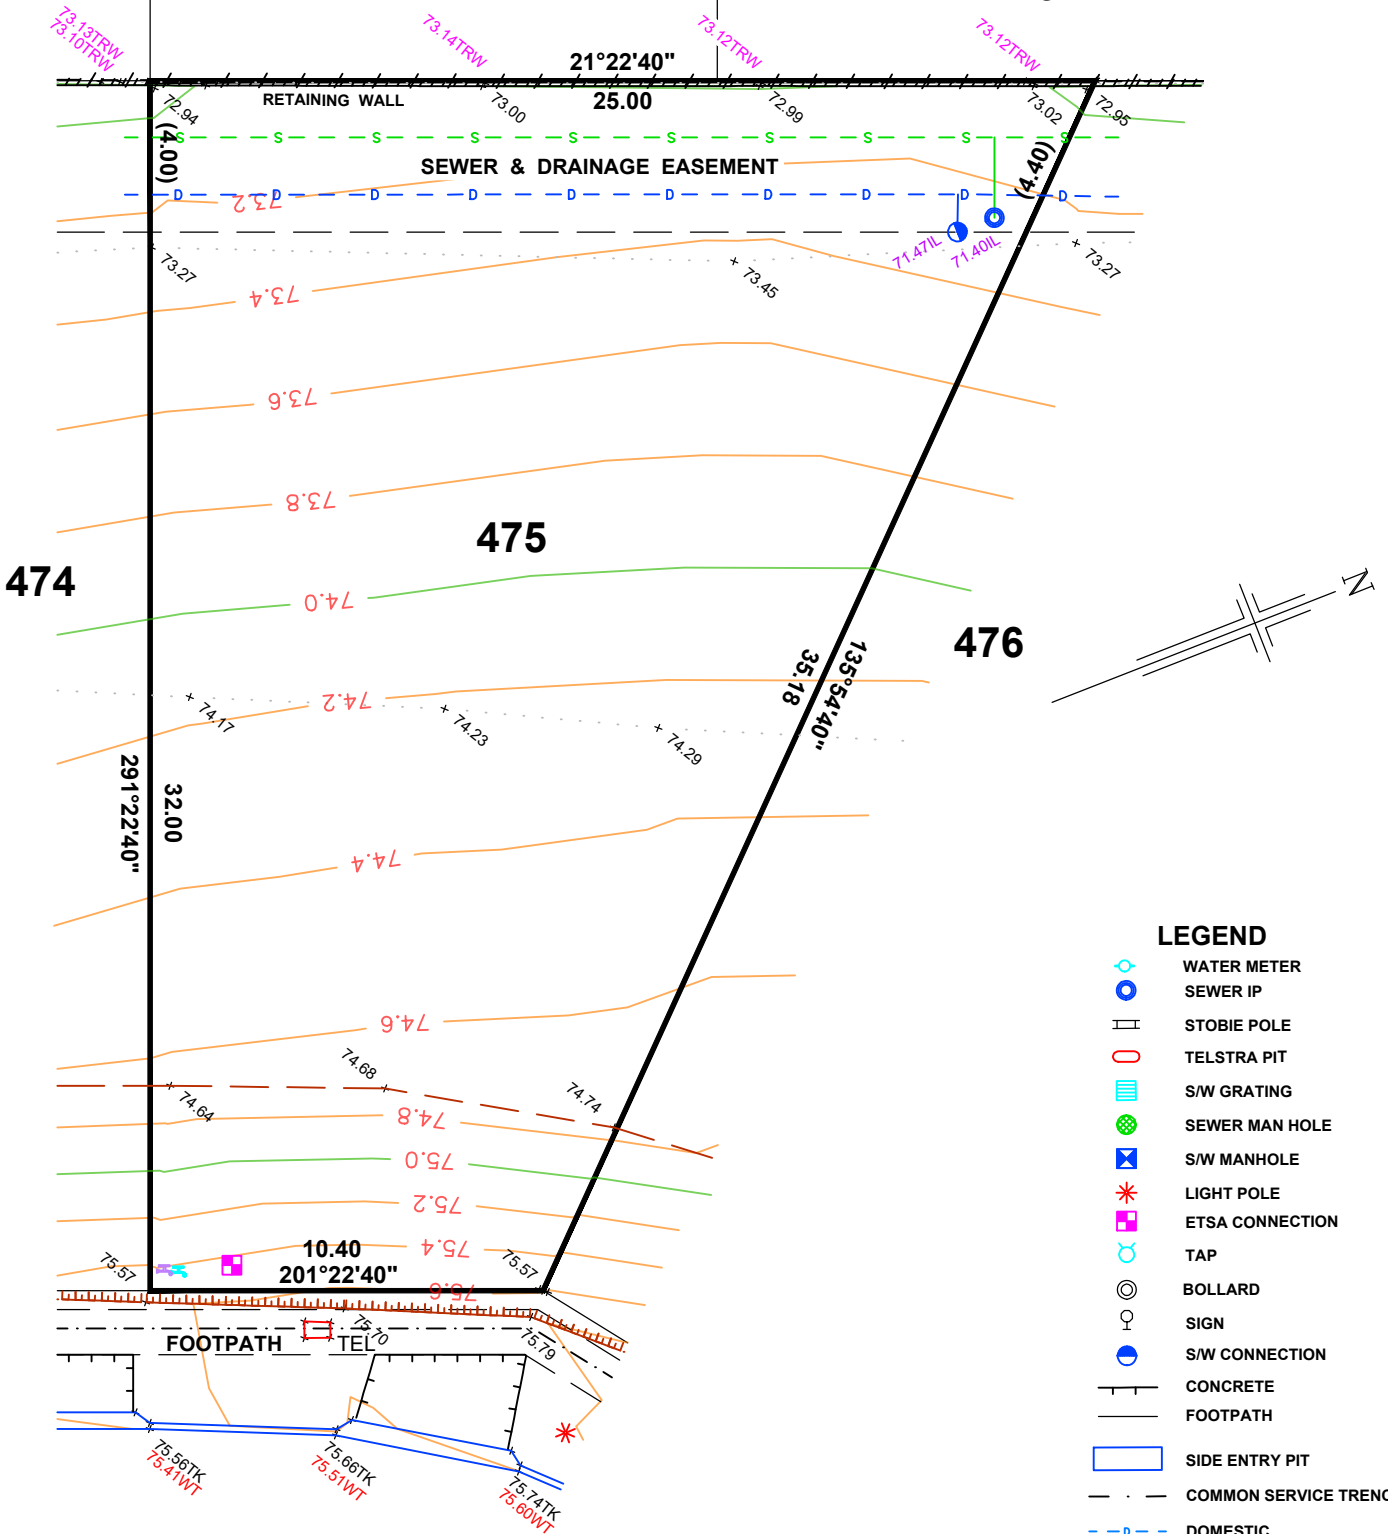

**LEGEND**

- WATER METER
- SEWER IP
- STOBIE POLE
- TELSTRA PIT
- S/W GRATING
- SEWER MAN HOLE
- S/W MANHOLE
- LIGHT POLE
- ETSA CONNECTION
- TAP
- BOLLARD
- SIGN
- S/W CONNECTION
- CONCRETE
- FOOTPATH
- SIDE ENTRY PIT
- COMMON SERVICE TRENCH
- DOMESTIC
- SEWER IO
- POTABLE WATER CONN
- NON-POTABLE WATER CONN
- 29.00TRW TOP RETAINING WALL
- 29.00IL INVERT LEVEL

**VERMONT ROAD**

NOTE: FOOTPATH & CST DATA SHOWN HEREON IS DESIGN INFORMATION AND SHOULD BE CONFIRMED.





ALEXANDER SYMONDS  
PH 8130 1666

1:200

ORIGINAL SHEET SIZE A4

ALLOTMENT 476 in DEV. NO. 145/D215/12/007  
in the area named  
**SEAFORD HEIGHTS**  
CT ---/---

**AS CONSTRUCTED**

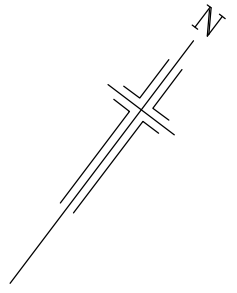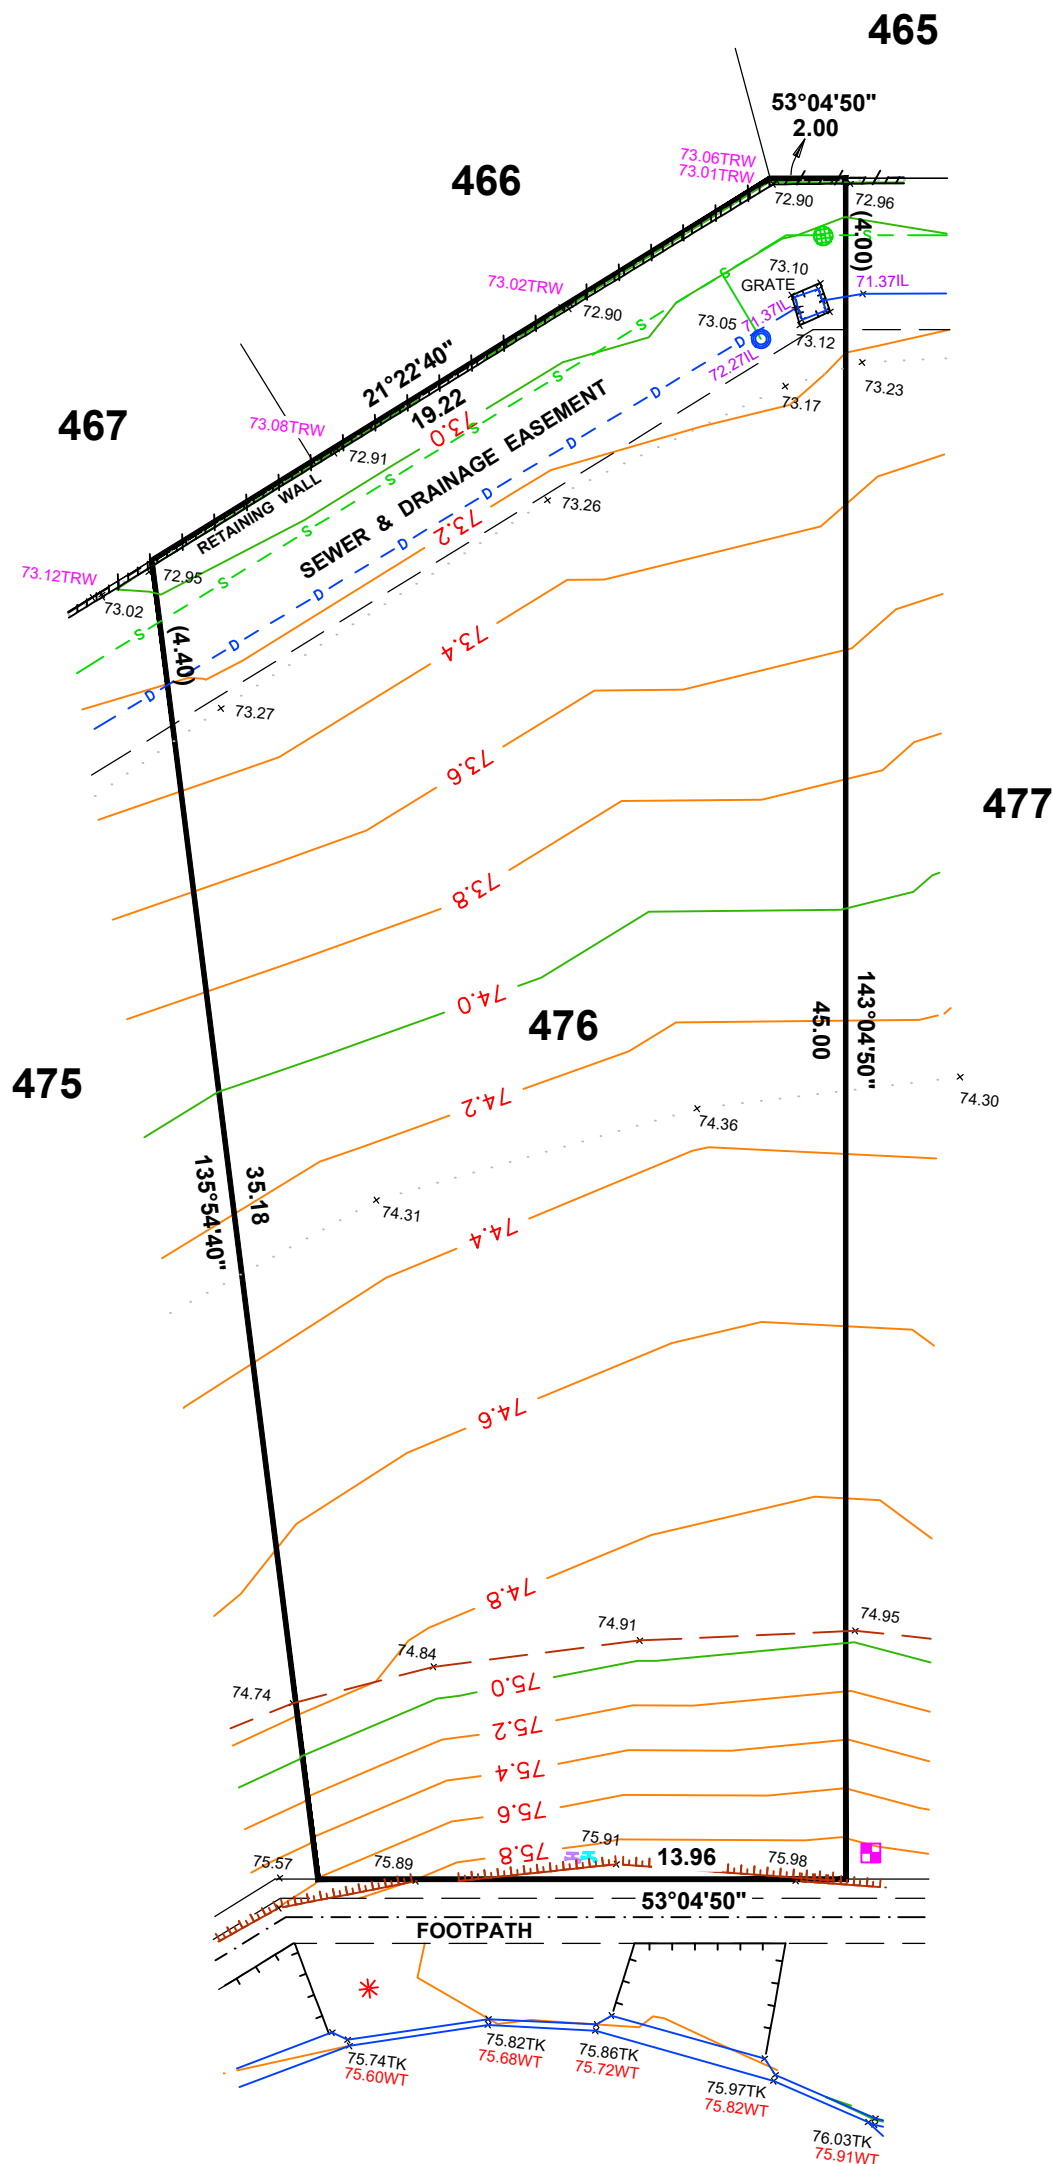


**LEGEND**

- WATER METER
- SEWER IP
- STOBIE POLE
- TELSTRA PIT
- S/W GRATING
- SEWER MAN HOLE
- S/W MANHOLE
- LIGHT POLE
- ETSA CONNECTION
- TAP
- BOLLARD
- SIGN
- S/W CONNECTION
- CONCRETE
- FOOTPATH
- SIDE ENTRY PIT
- COMMON SERVICE TRENCH
- DOMESTIC
- SEWER IO
- POTABLE WATER CONN
- NON-POTABLE WATER CONN
- 29.00TRW TOP RETAINING WALL
- 29.00IL INVERT LEVEL

NOTE: FOOTPATH & CST DATA SHOWN HEREON IS DESIGN INFORMATION AND SHOULD BE CONFIRMED.

NOTE: DATA SHOWN HEREON IS DESIGN INFORMATION AND SHOULD BE CONFIRMED.

ALEXANDER SYMONDS  
PH 8130 1666


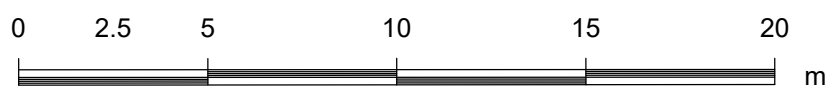


SCALE 1:200

ORIGINAL SHEET SIZE A3

ALLOTMENT 477 in DEV. NO. 145/D215/12/007  
in the area named  
**SEAFORD HEIGHTS**  
CT ---/---

**AS CONSTRUCTED**

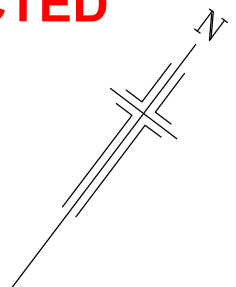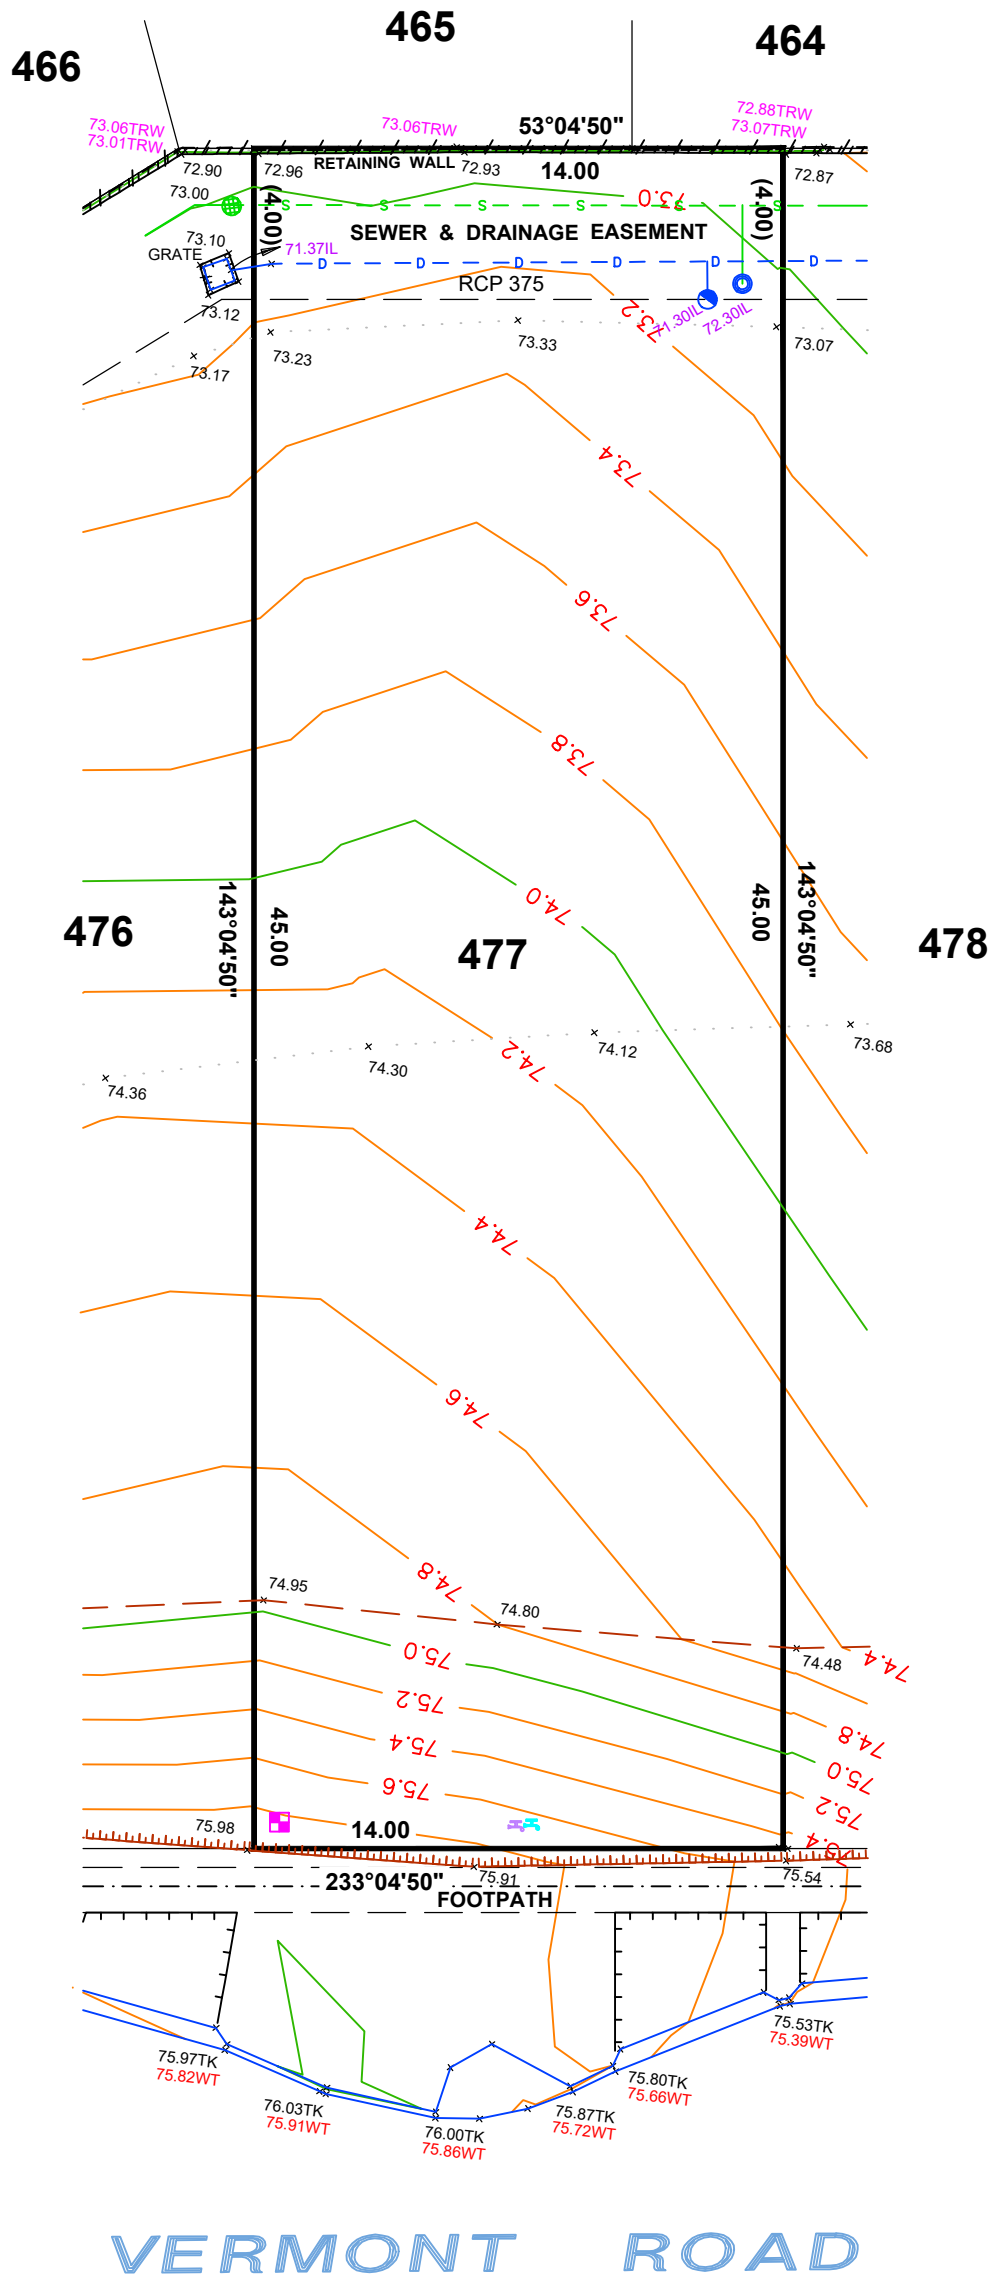

**LEGEND**

- WATER METER
- SEWER IP
- STOBIE POLE
- TELSTRA PIT
- S/W GRATING
- SEWER MAN HOLE
- S/W MANHOLE
- LIGHT POLE
- ETSA CONNECTION
- TAP
- BOLLARD
- SIGN
- S/W CONNECTION
- CONCRETE
- FOOTPATH
- SIDE ENTRY PIT
- COMMON SERVICE TRENCH
- DOMESTIC
- SEWER IO
- POTABLE WATER CONN
- NON-POTABLE WATER CONN
- 29.00TRW TOP RETAINING WALL
- 29.00IL INVERT LEVEL



NOTE: FOOTPATH & CST DATA SHOWN HEREON IS DESIGN INFORMATION AND SHOULD BE CONFIRMED.



SCALE 1:200

ALLOTMENT 478 in DEV. NO. 145/D215/12/007  
in the area named  
**SEAFORD HEIGHTS**  
CT ---/----

**AS CONSTRUCTED**

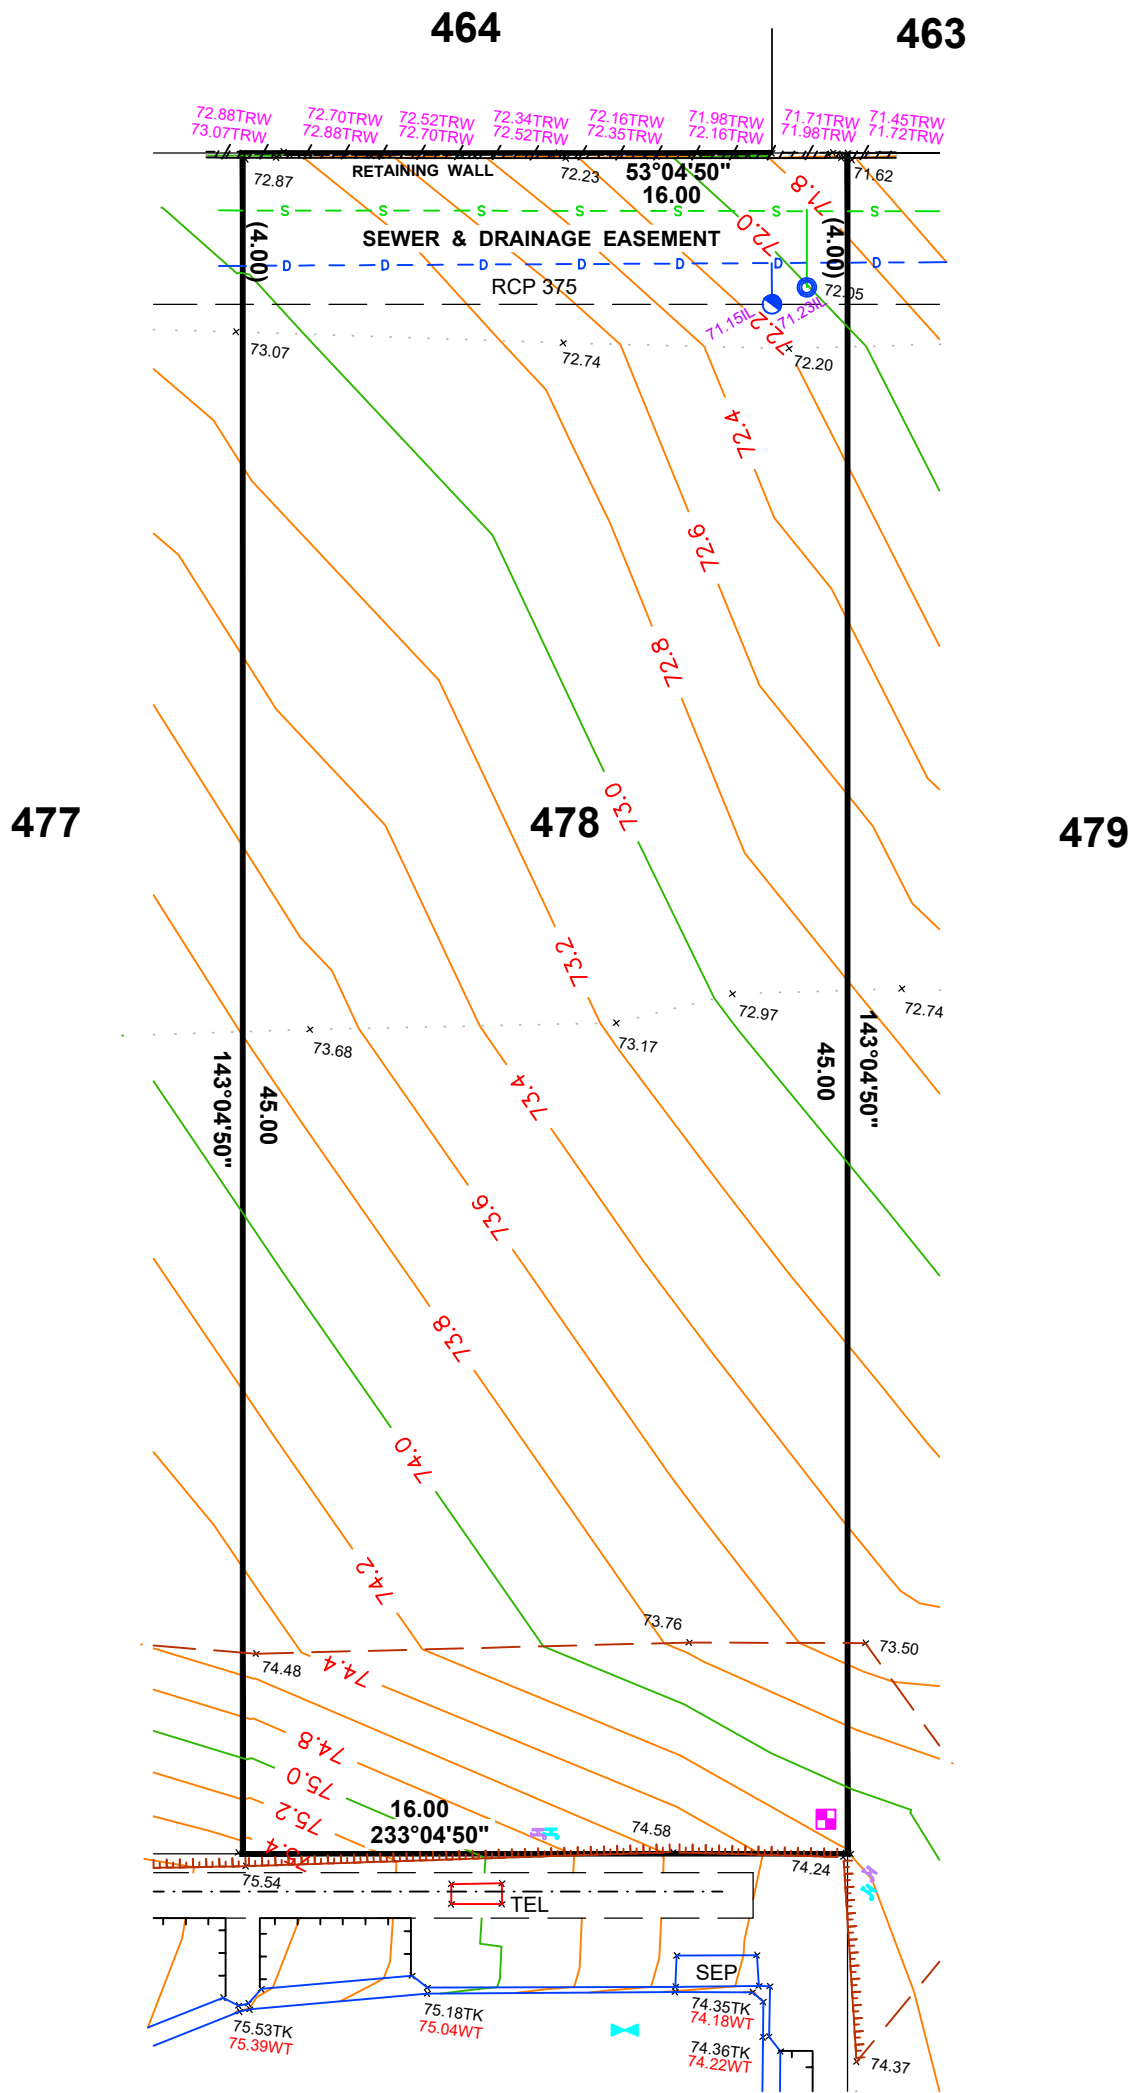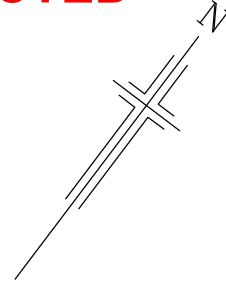

**VERMONT ROAD**

**LEGEND**

- WATER METER
- SEWER IP
- STOBIE POLE
- TELSTRA PIT
- S/W GRATING
- SEWER MAN HOLE
- S/W MANHOLE
- LIGHT POLE
- ETSA CONNECTION
- TAP
- BOLLARD
- SIGN
- S/W CONNECTION
- CONCRETE
- FOOTPATH
- SIDE ENTRY PIT
- COMMON SERVICE TRENCH
- DOMESTIC
- SEWER IO
- POTABLE WATER CONN
- NON-POTABLE WATER CONN
- 29.00TRW
- 29.00IL

NOTE: FOOTPATH & CST DATA SHOWN HEREON IS DESIGN INFORMATION AND SHOULD BE CONFIRMED.



SCALE 1:200

ALLOTMENT 479 in DEV. NO. 145/D215/12/007  
in the area named  
SEAFORD HEIGHTS

**AS CONSTRUCTED**

464

463



478

479

1005

480

VERMONT  
ROAD

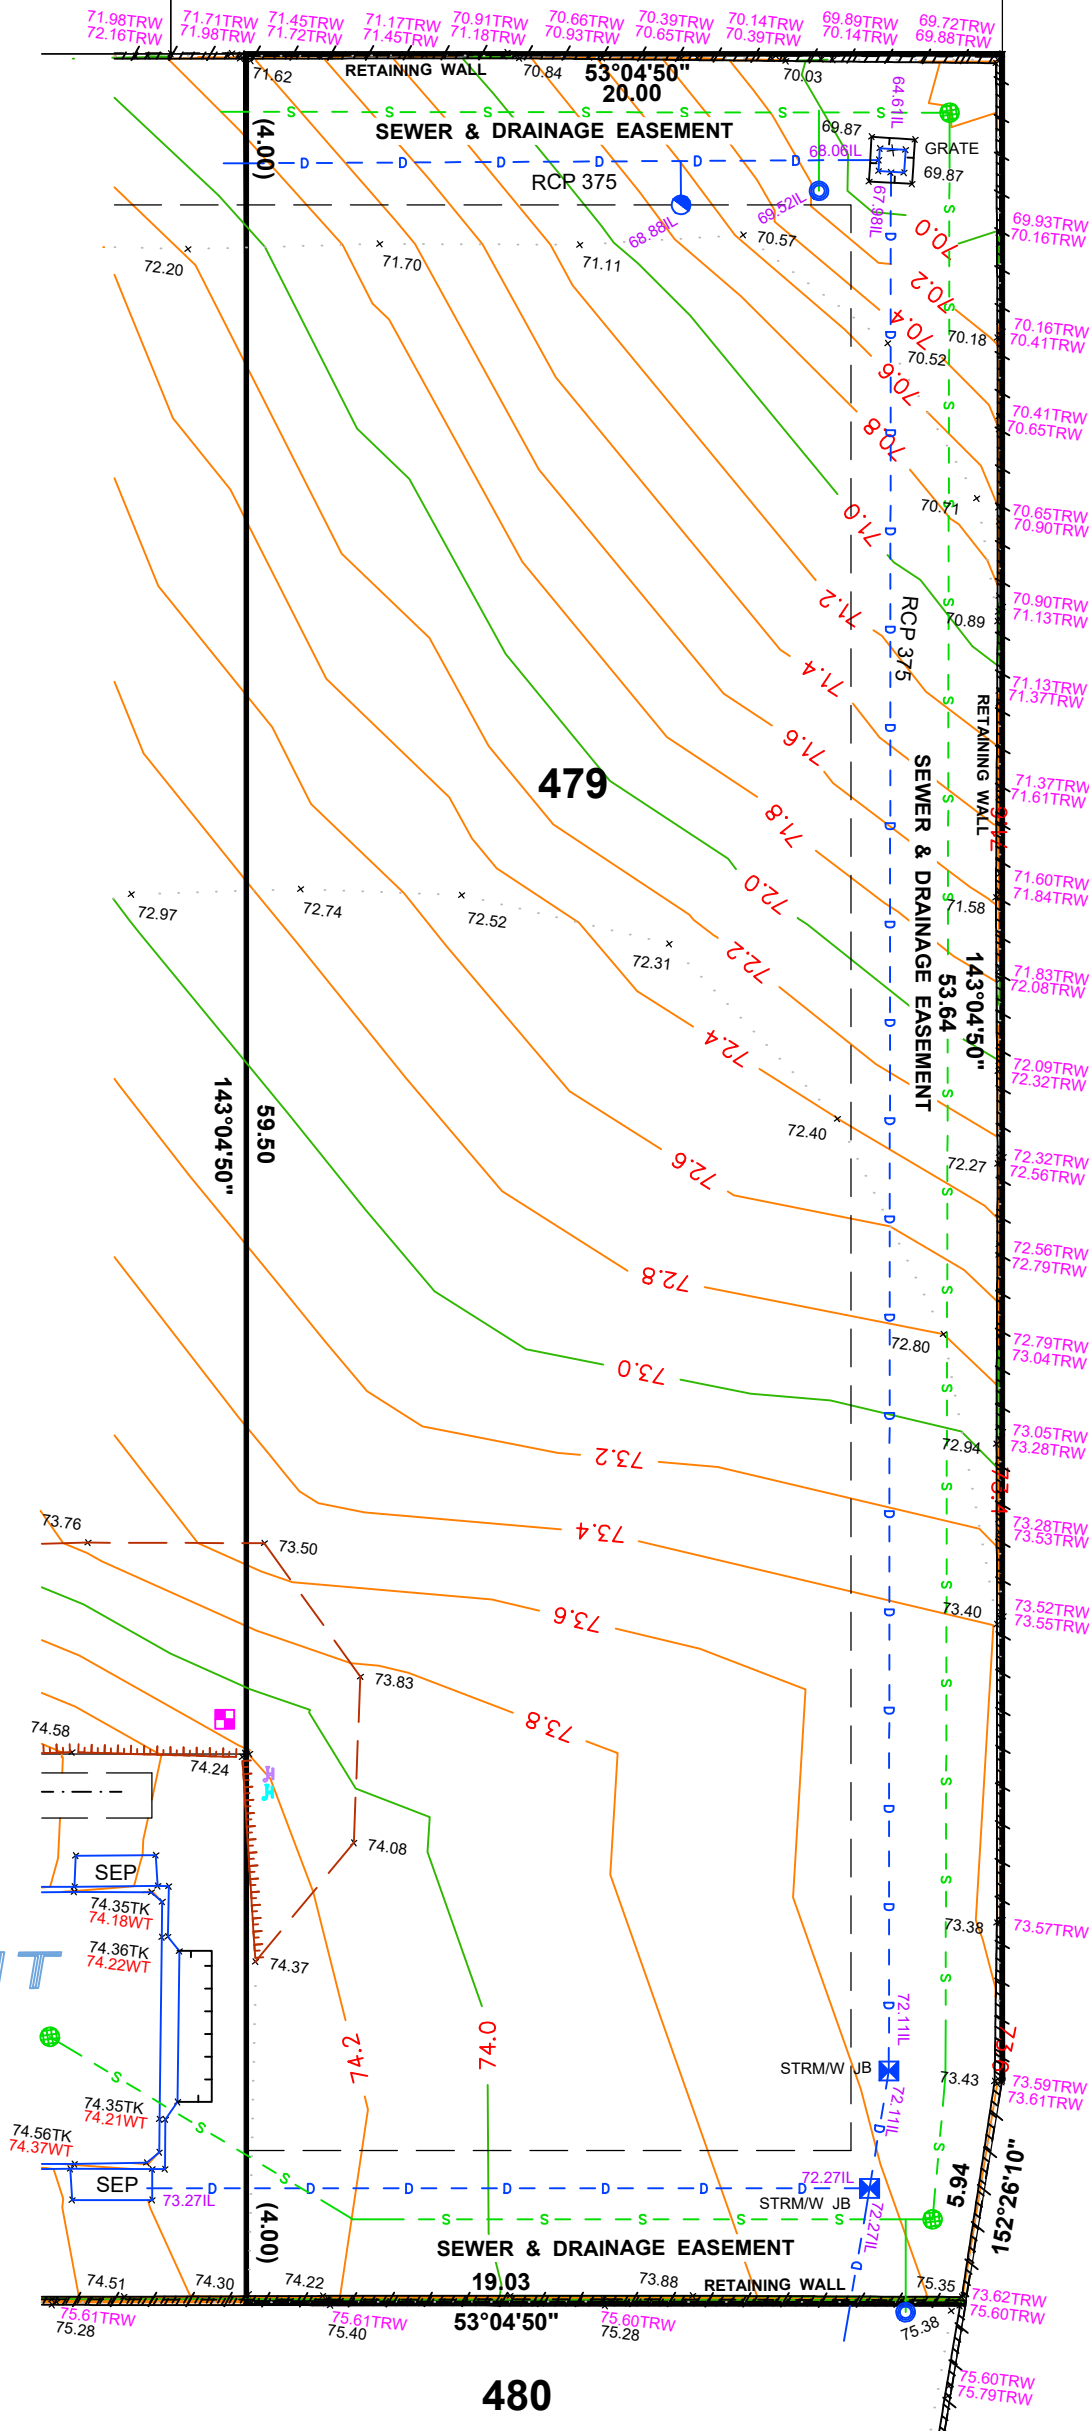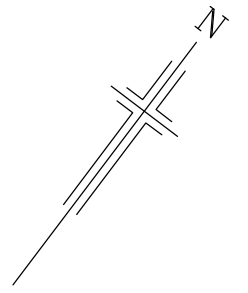

**LEGEND**

- WATER METER
- SEWER IP
- STOBIE POLE
- TELSTRA PIT
- S/W GRATING
- SEWER MAN HOLE
- S/W MANHOLE
- LIGHT POLE
- ETSA CONNECTION
- TAP
- BOLLARD
- SIGN
- S/W CONNECTION
- CONCRETE
- FOOTPATH
- SIDE ENTRY PIT
- COMMON SERVICE TRENCH
- DOMESTIC
- SEWER IO
- POTABLE WATER CONN
- NON-POTABLE WATER CONN
- 29.00TRW TOP RETAINING WALL
- 29.00IL INVERT LEVEL

NOTE: FOOTPATH & CST DATA SHOWN HEREON IS DESIGN INFORMATION AND SHOULD BE CONFIRMED.





SCALE 1:200



ALLOTMENT 480 in DEV. NO. 145/D215/12/007  
in the area named  
**SEAFORD HEIGHTS**  
CT ---/----

**AS CONSTRUCTED**

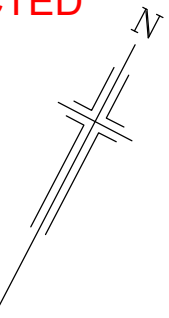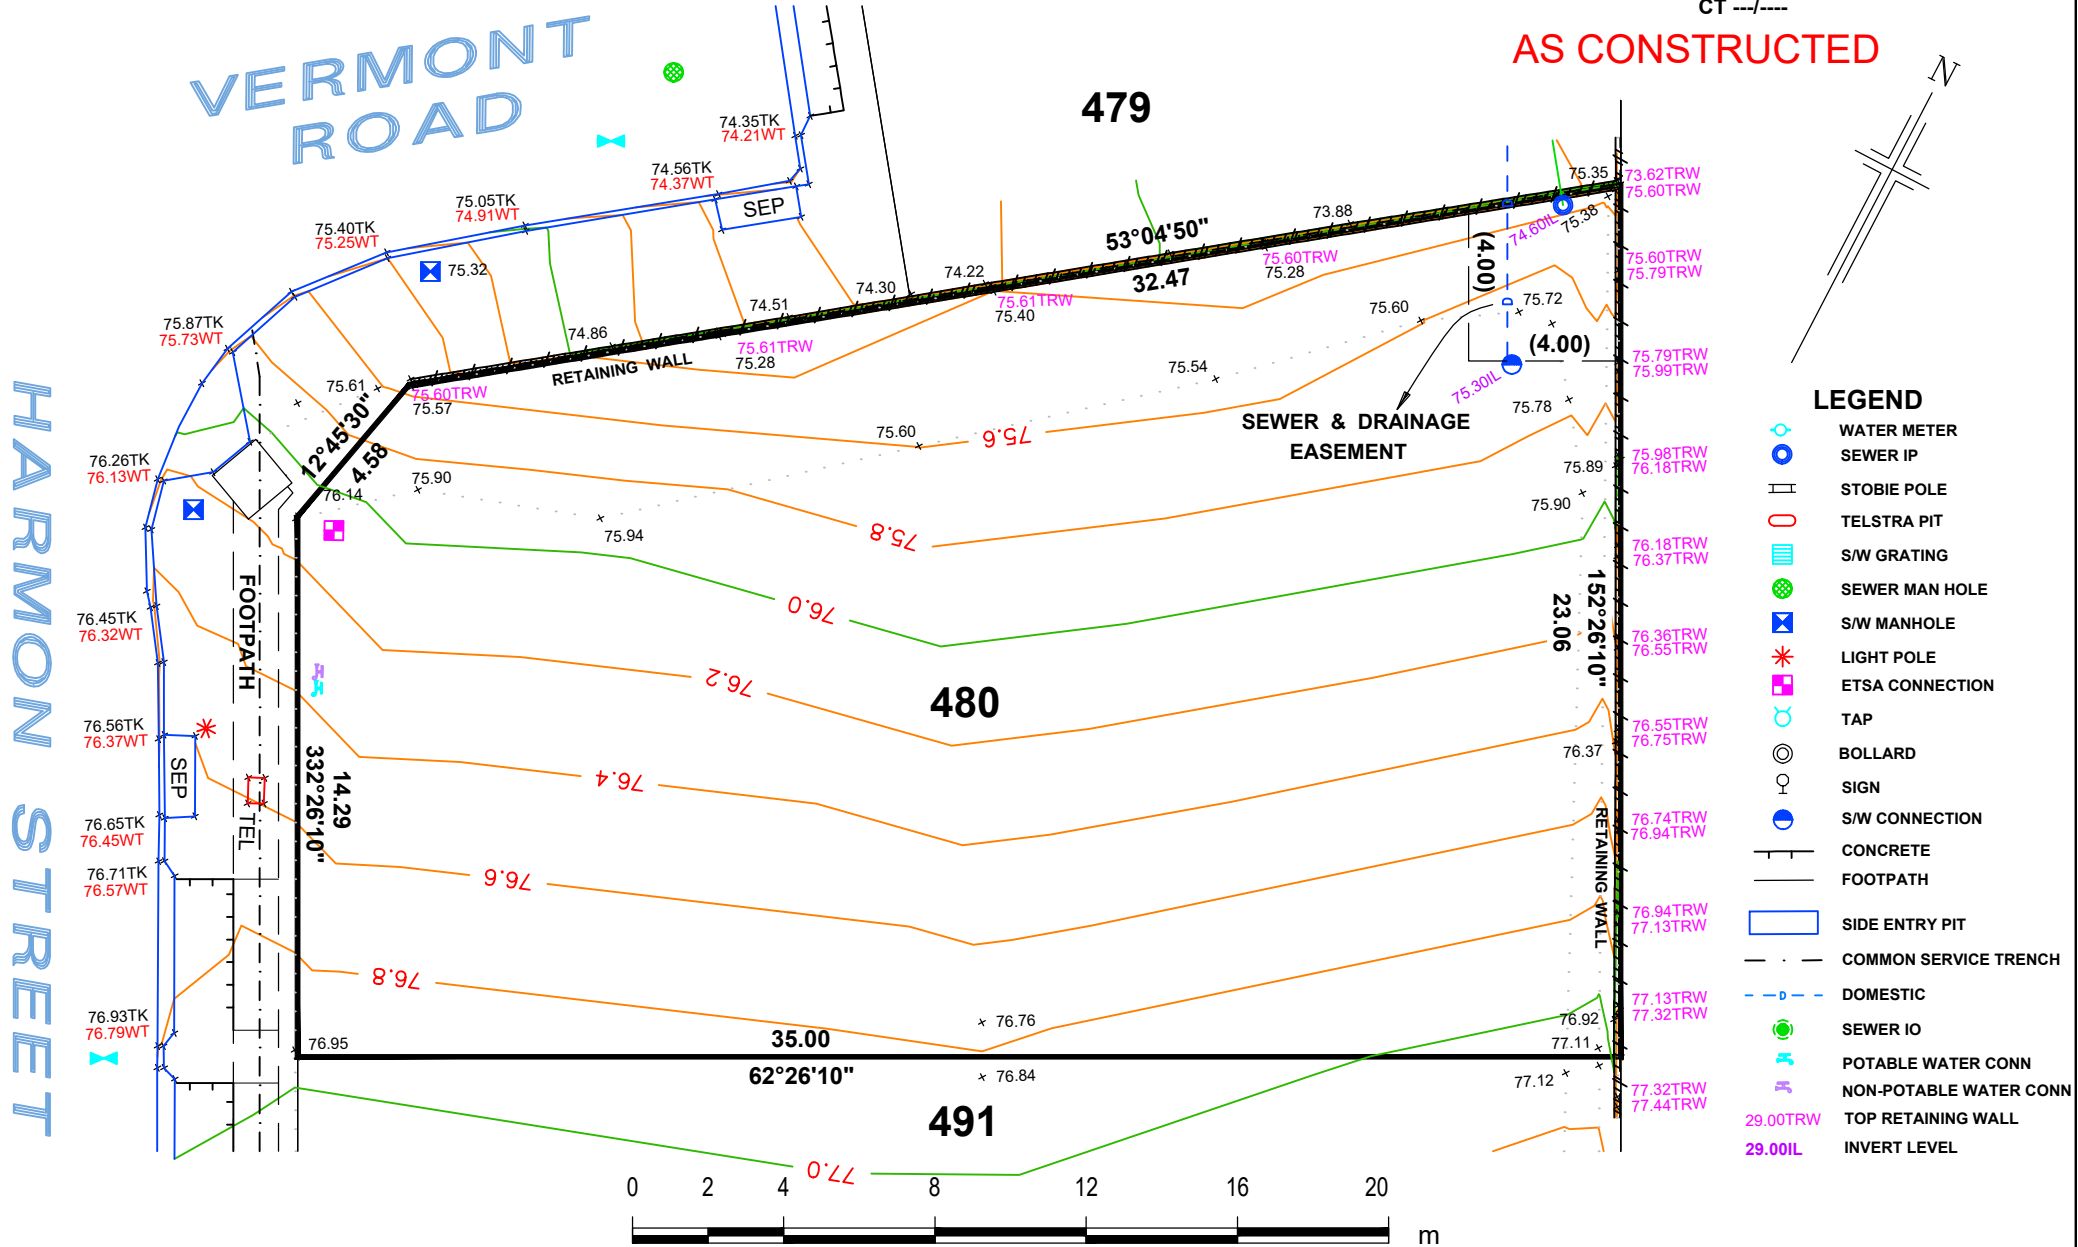

- LEGEND**
- WATER METER
  - SEWER IP
  - STOBIE POLE
  - TELSTRA PIT
  - S/W GRATING
  - SEWER MAN HOLE
  - S/W MANHOLE
  - LIGHT POLE
  - E.T.S.A CONNECTION
  - TAP
  - BOLLARD
  - SIGN
  - S/W CONNECTION
  - CONCRETE
  - FOOTPATH
  - SIDE ENTRY PIT
  - COMMON SERVICE TRENCH
  - DOMESTIC
  - SEWER IO
  - POTABLE WATER CONN
  - NON-POTABLE WATER CONN
  - 29.00TRW TOP RETAINING WALL
  - 29.00IIL INVERT LEVEL



1:200

ALEXANDER SYMONDS  
PH 8130 1666

NOTE: FOOTPATH & CST DATA SHOWN HEREON IS DESIGN INFORMATION AND SHOULD BE CONFIRMED  
ORIGINAL SHEET SIZE A4

ALLOTMENT 481 in DEV. NO. 145/D215/12/007


in the area named  
**SEAFORD HEIGHTS**

CT ---/----

**AS CONSTRUCTED**

**VERMONT ROAD**

**HARMON STREET**

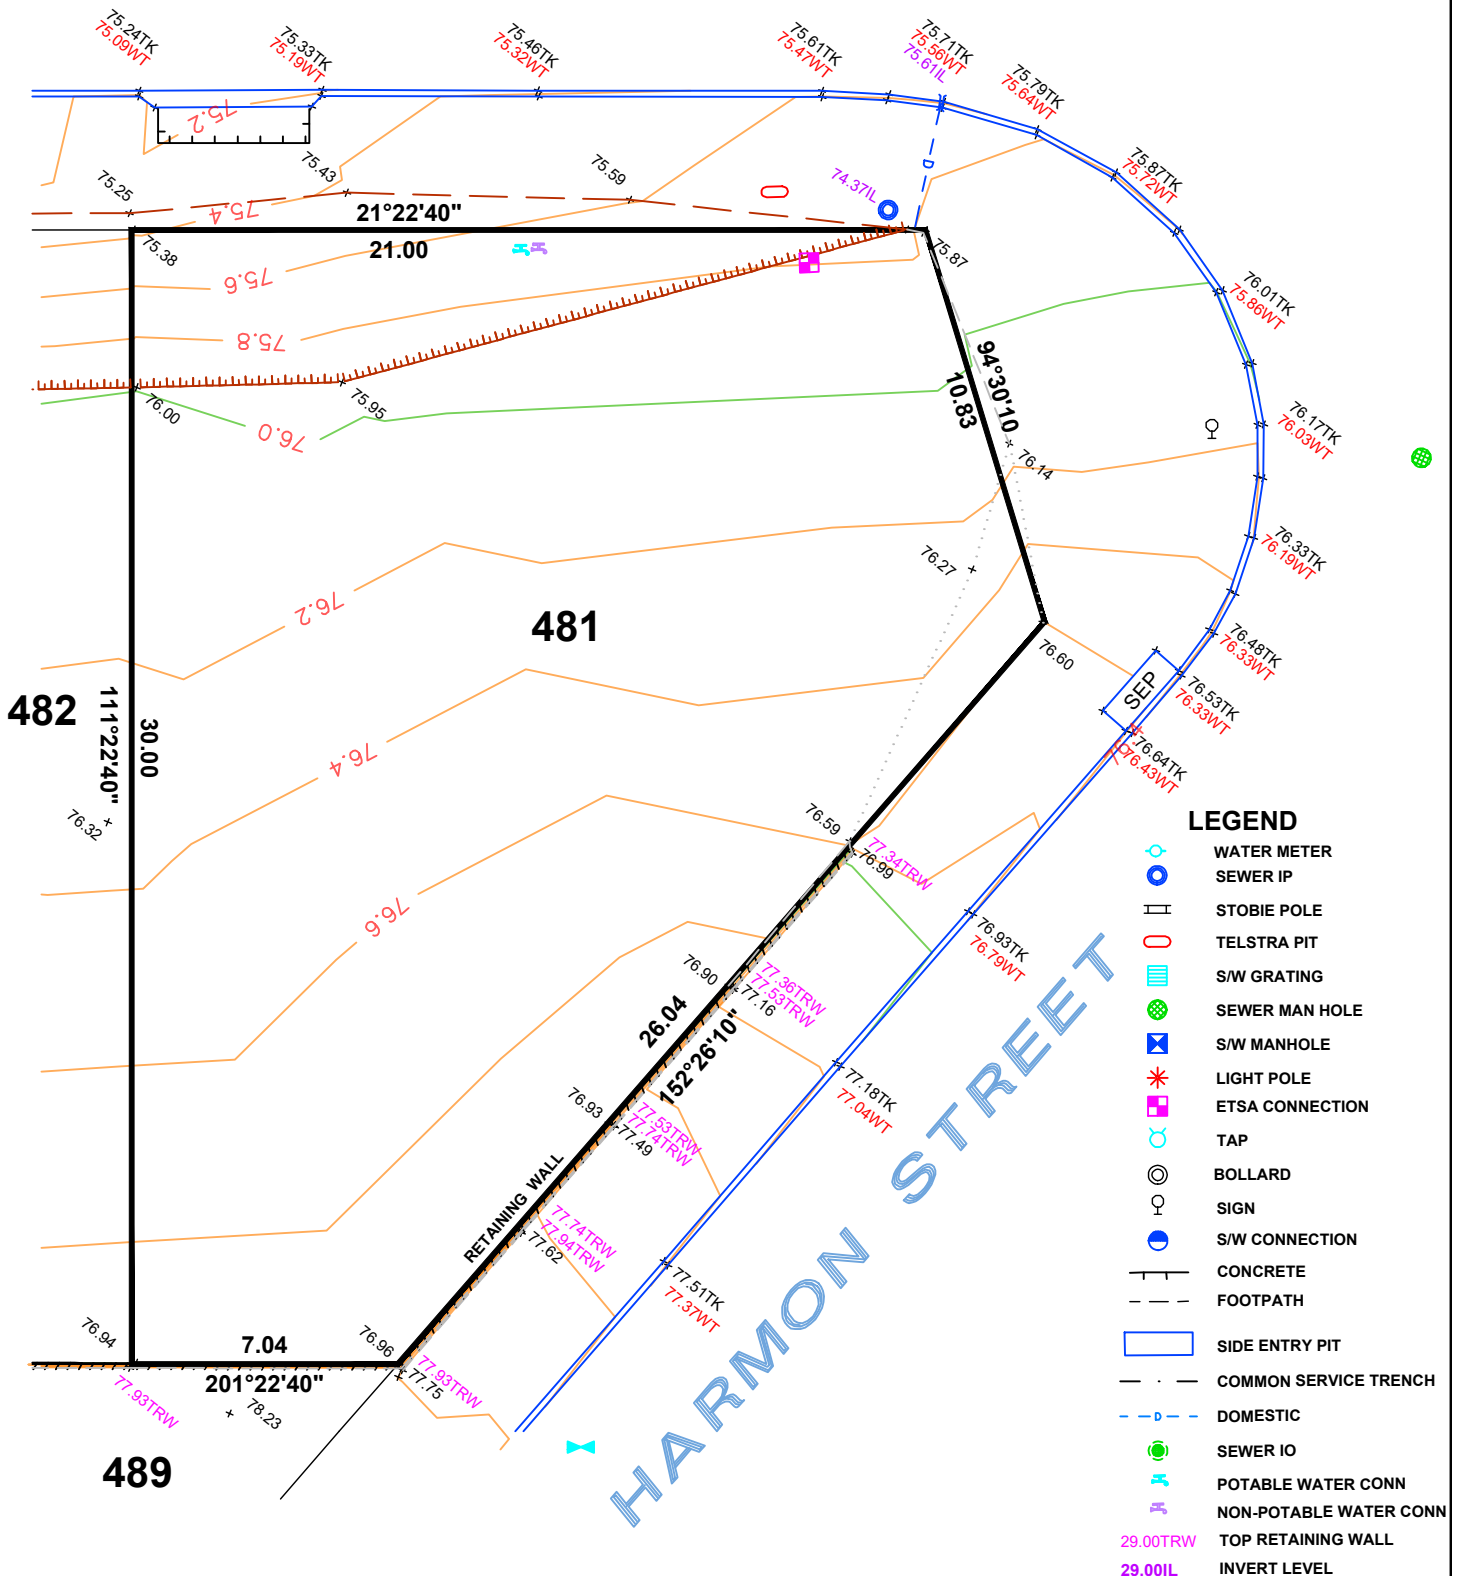

**LEGEND**

- WATER METER
- SEWER IP
- STOBIE POLE
- TELSTRA PIT
- S/W GRATING
- SEWER MAN HOLE
- S/W MANHOLE
- LIGHT POLE
- ETSA CONNECTION
- TAP
- BOLLARD
- SIGN
- S/W CONNECTION
- CONCRETE
- FOOTPATH
- SIDE ENTRY PIT
- COMMON SERVICE TRENCH
- DOMESTIC
- SEWER IO
- POTABLE WATER CONN
- NON-POTABLE WATER CONN
- 29.00TRW TOP RETAINING WALL
- 29.00IL INVERT LEVEL



1:200

ALEXANDER SYMONDS  
PH 8130 1666

ORIGINAL SHEET SIZE A4



ALLOTMENT 482 in DEV. NO. 145/D215/12/007

in the area named  
**SEAFORD HEIGHTS**

CT ---/----

**AS CONSTRUCTED**

**VERMONT ROAD**

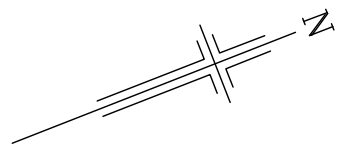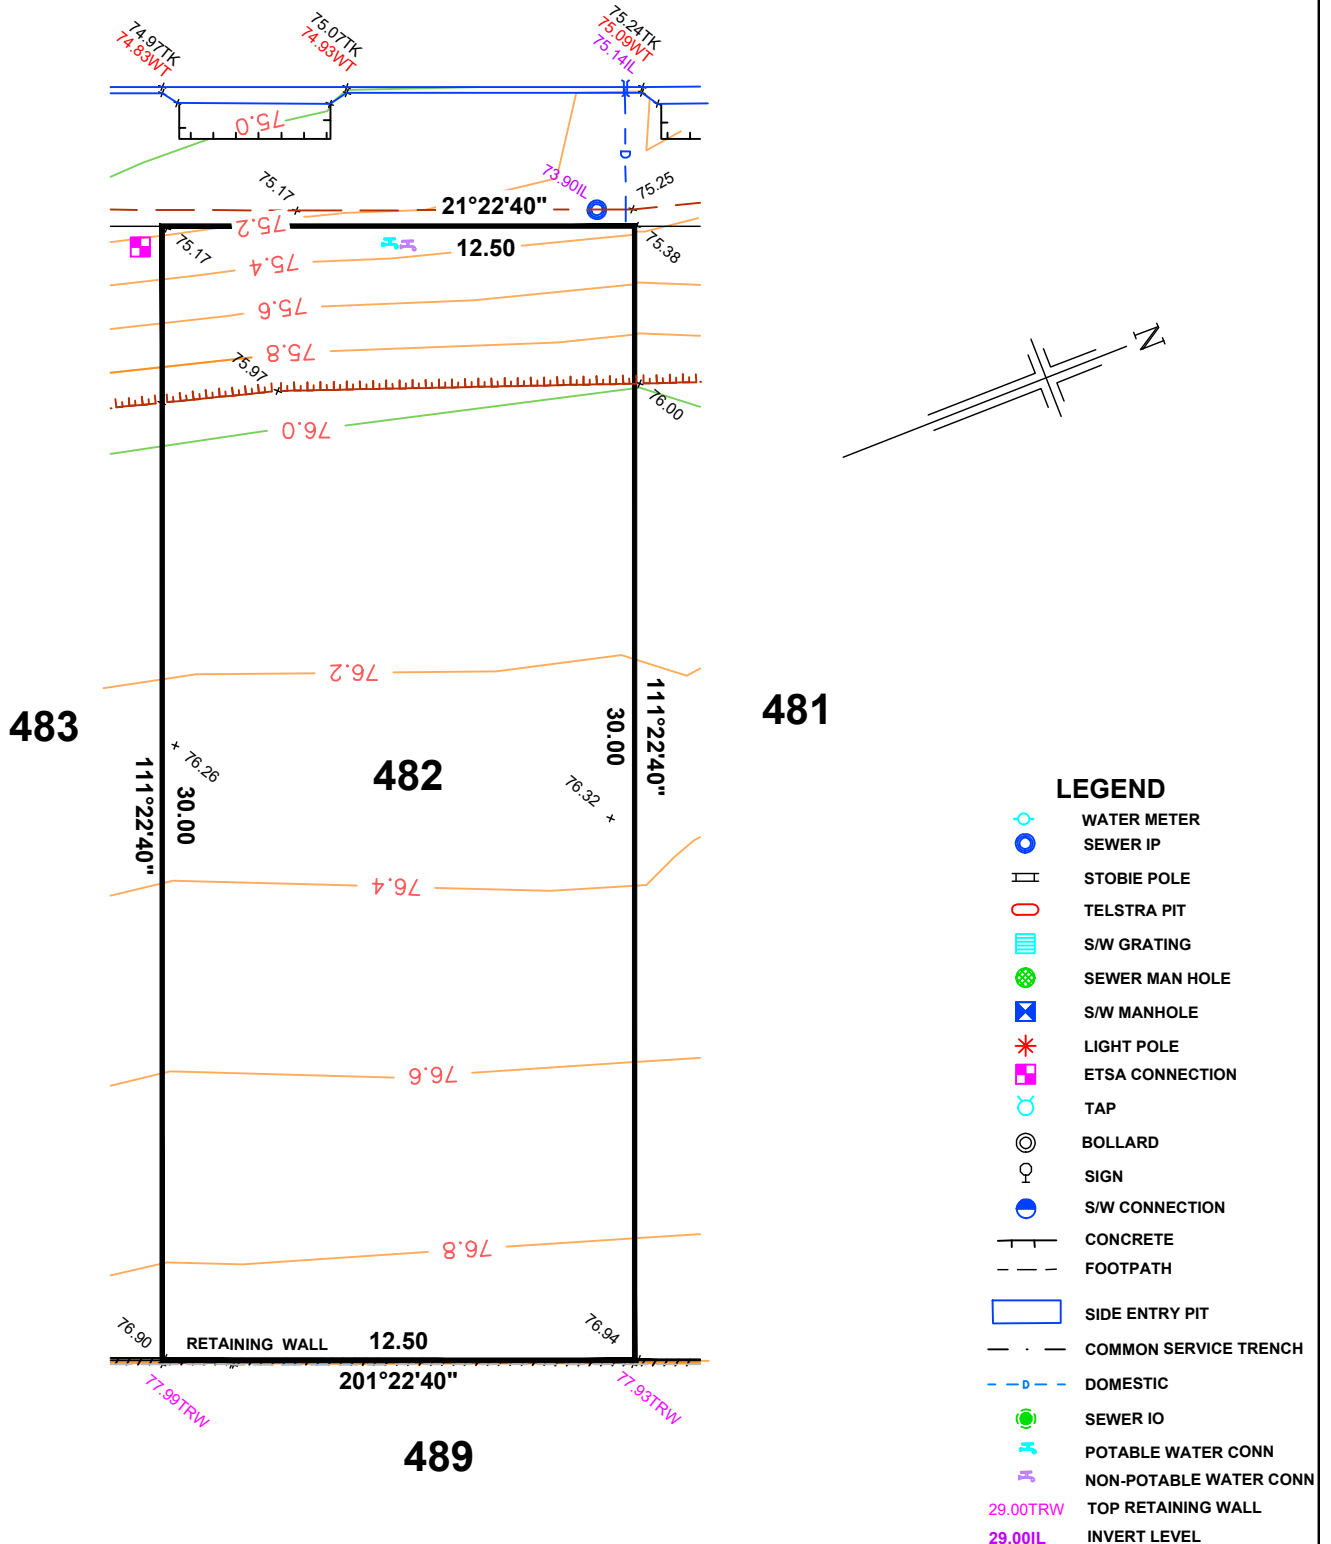

**LEGEND**

- WATER METER
- SEWER IP
- STOBIE POLE
- TELSTRA PIT
- S/W GRATING
- SEWER MAN HOLE
- S/W MANHOLE
- LIGHT POLE
- ETSA CONNECTION
- TAP
- BOLLARD
- SIGN
- S/W CONNECTION
- CONCRETE
- FOOTPATH
- SIDE ENTRY PIT
- COMMON SERVICE TRENCH
- DOMESTIC
- SEWER IO
- POTABLE WATER CONN
- NON-POTABLE WATER CONN
- 29.00TRW TOP RETAINING WALL
- 29.00IL INVERT LEVEL



1:200


ALLOTMENT 483 in DEV. NO. 145/D215/12/007

in the area named  
**SEAFORD HEIGHTS**

CT ---/----

**AS CONSTRUCTED**

**VERMONT ROAD**

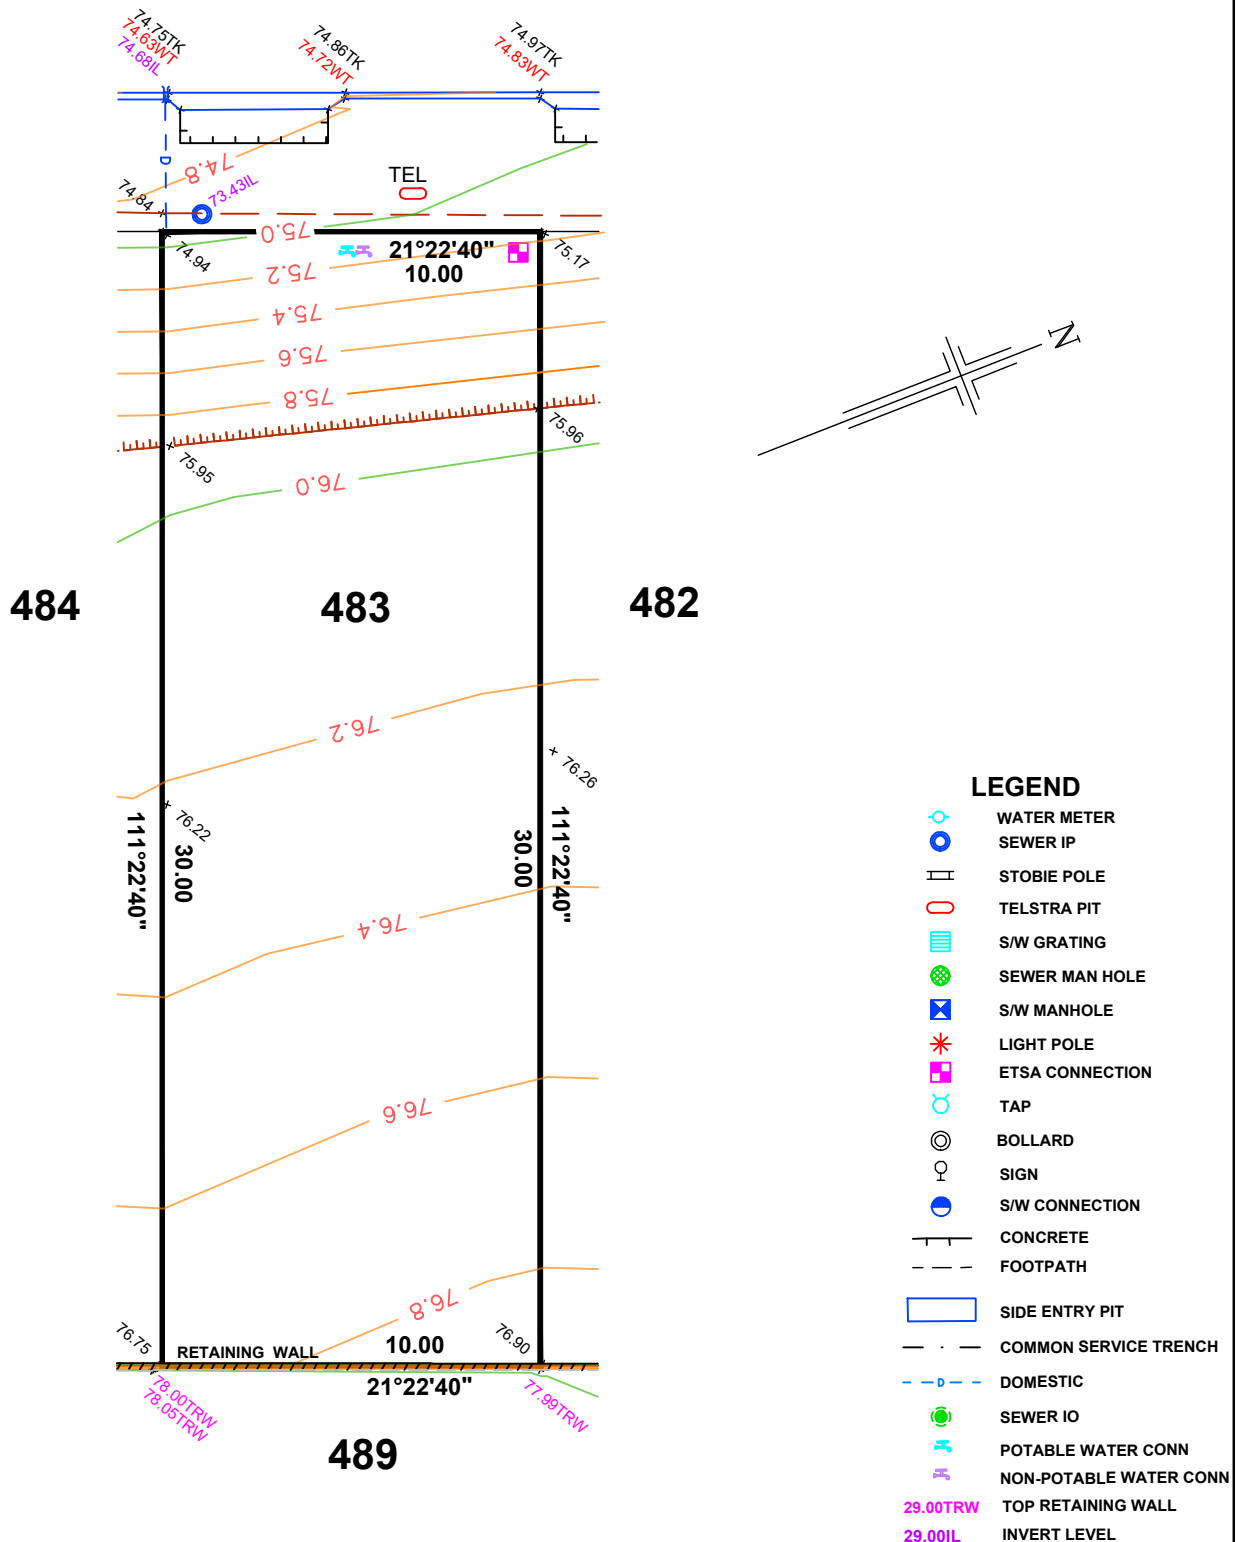


ALLOTMENT 484 in DEV. NO. 145/D215/12/007

in the area named  
**SEAFORD HEIGHTS**

CT ---/----

**AS CONSTRUCTED**

# VERMONT ROAD


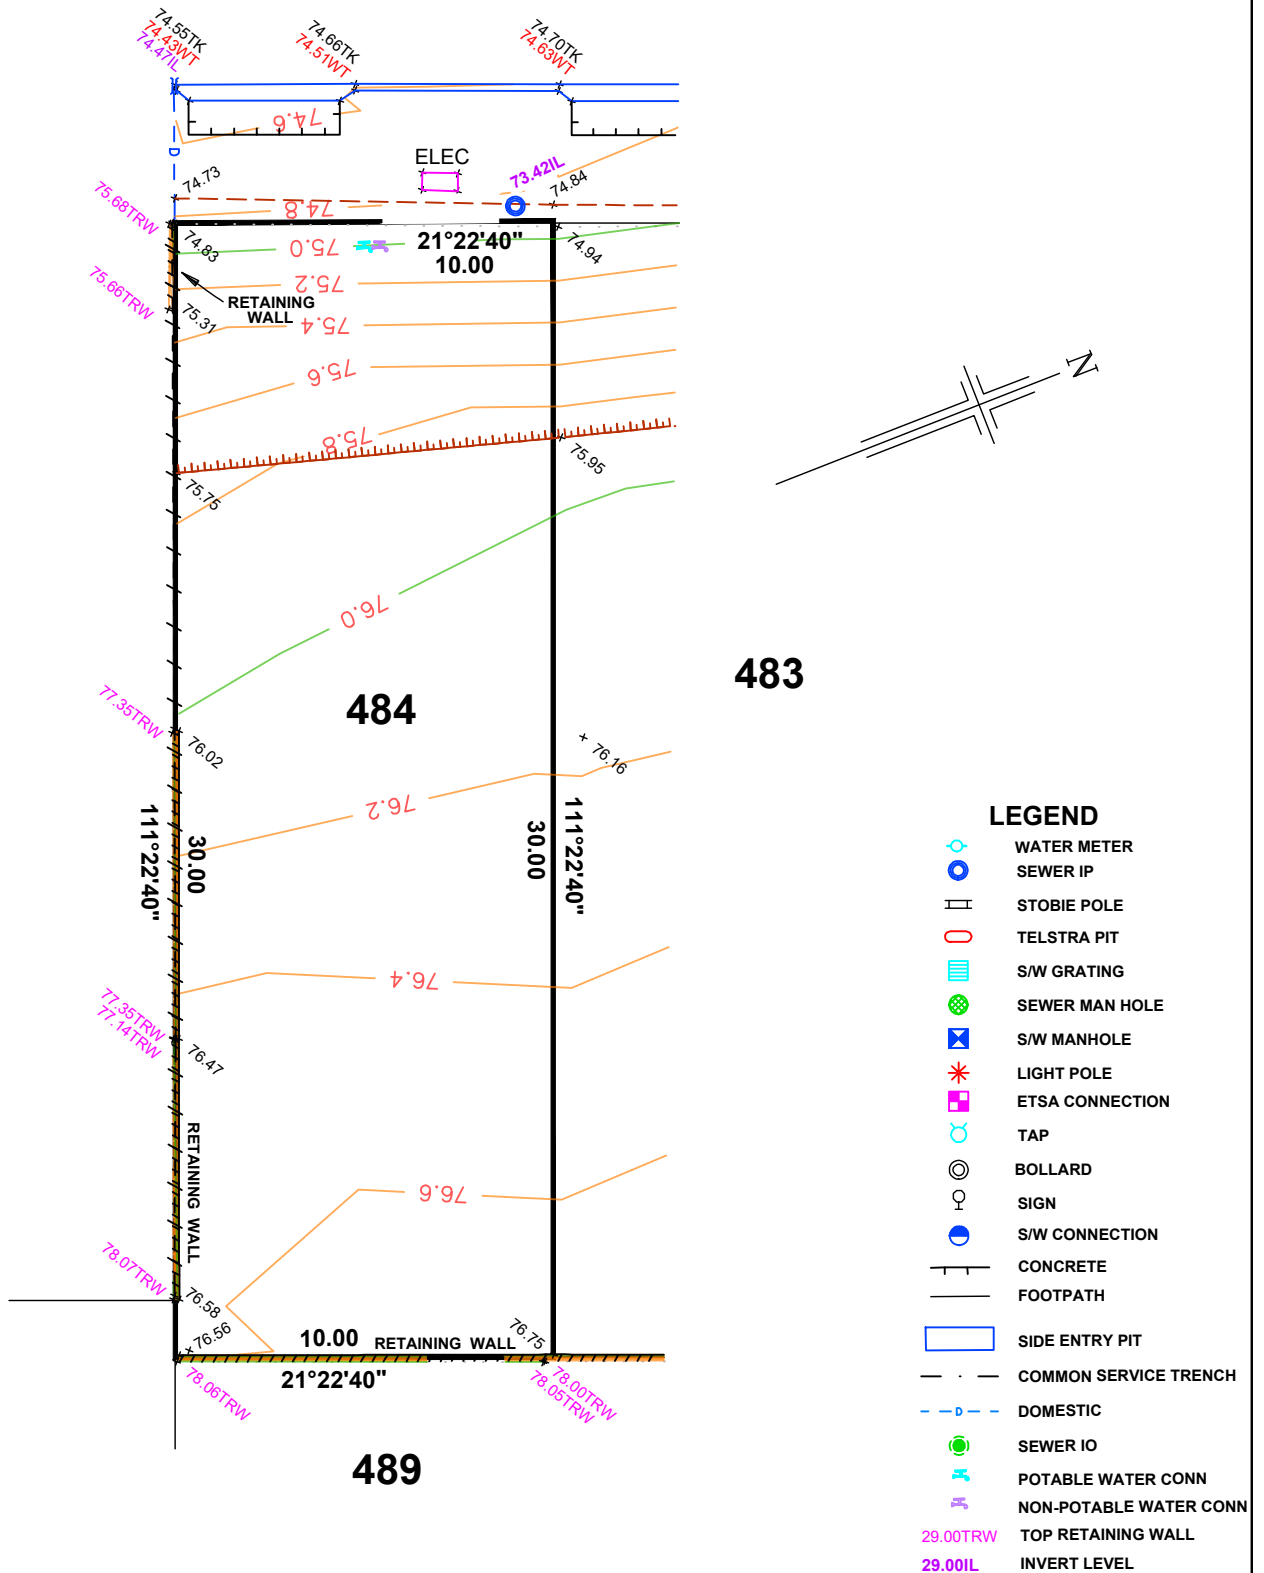


1:200

ALLOTMENT 489 in DEV. NO. 145/D215/12/008  
in the area named  
**SEAFORD HEIGHTS**  
CT ---/----

**AS CONSTRUCTED**

HARMON STREET

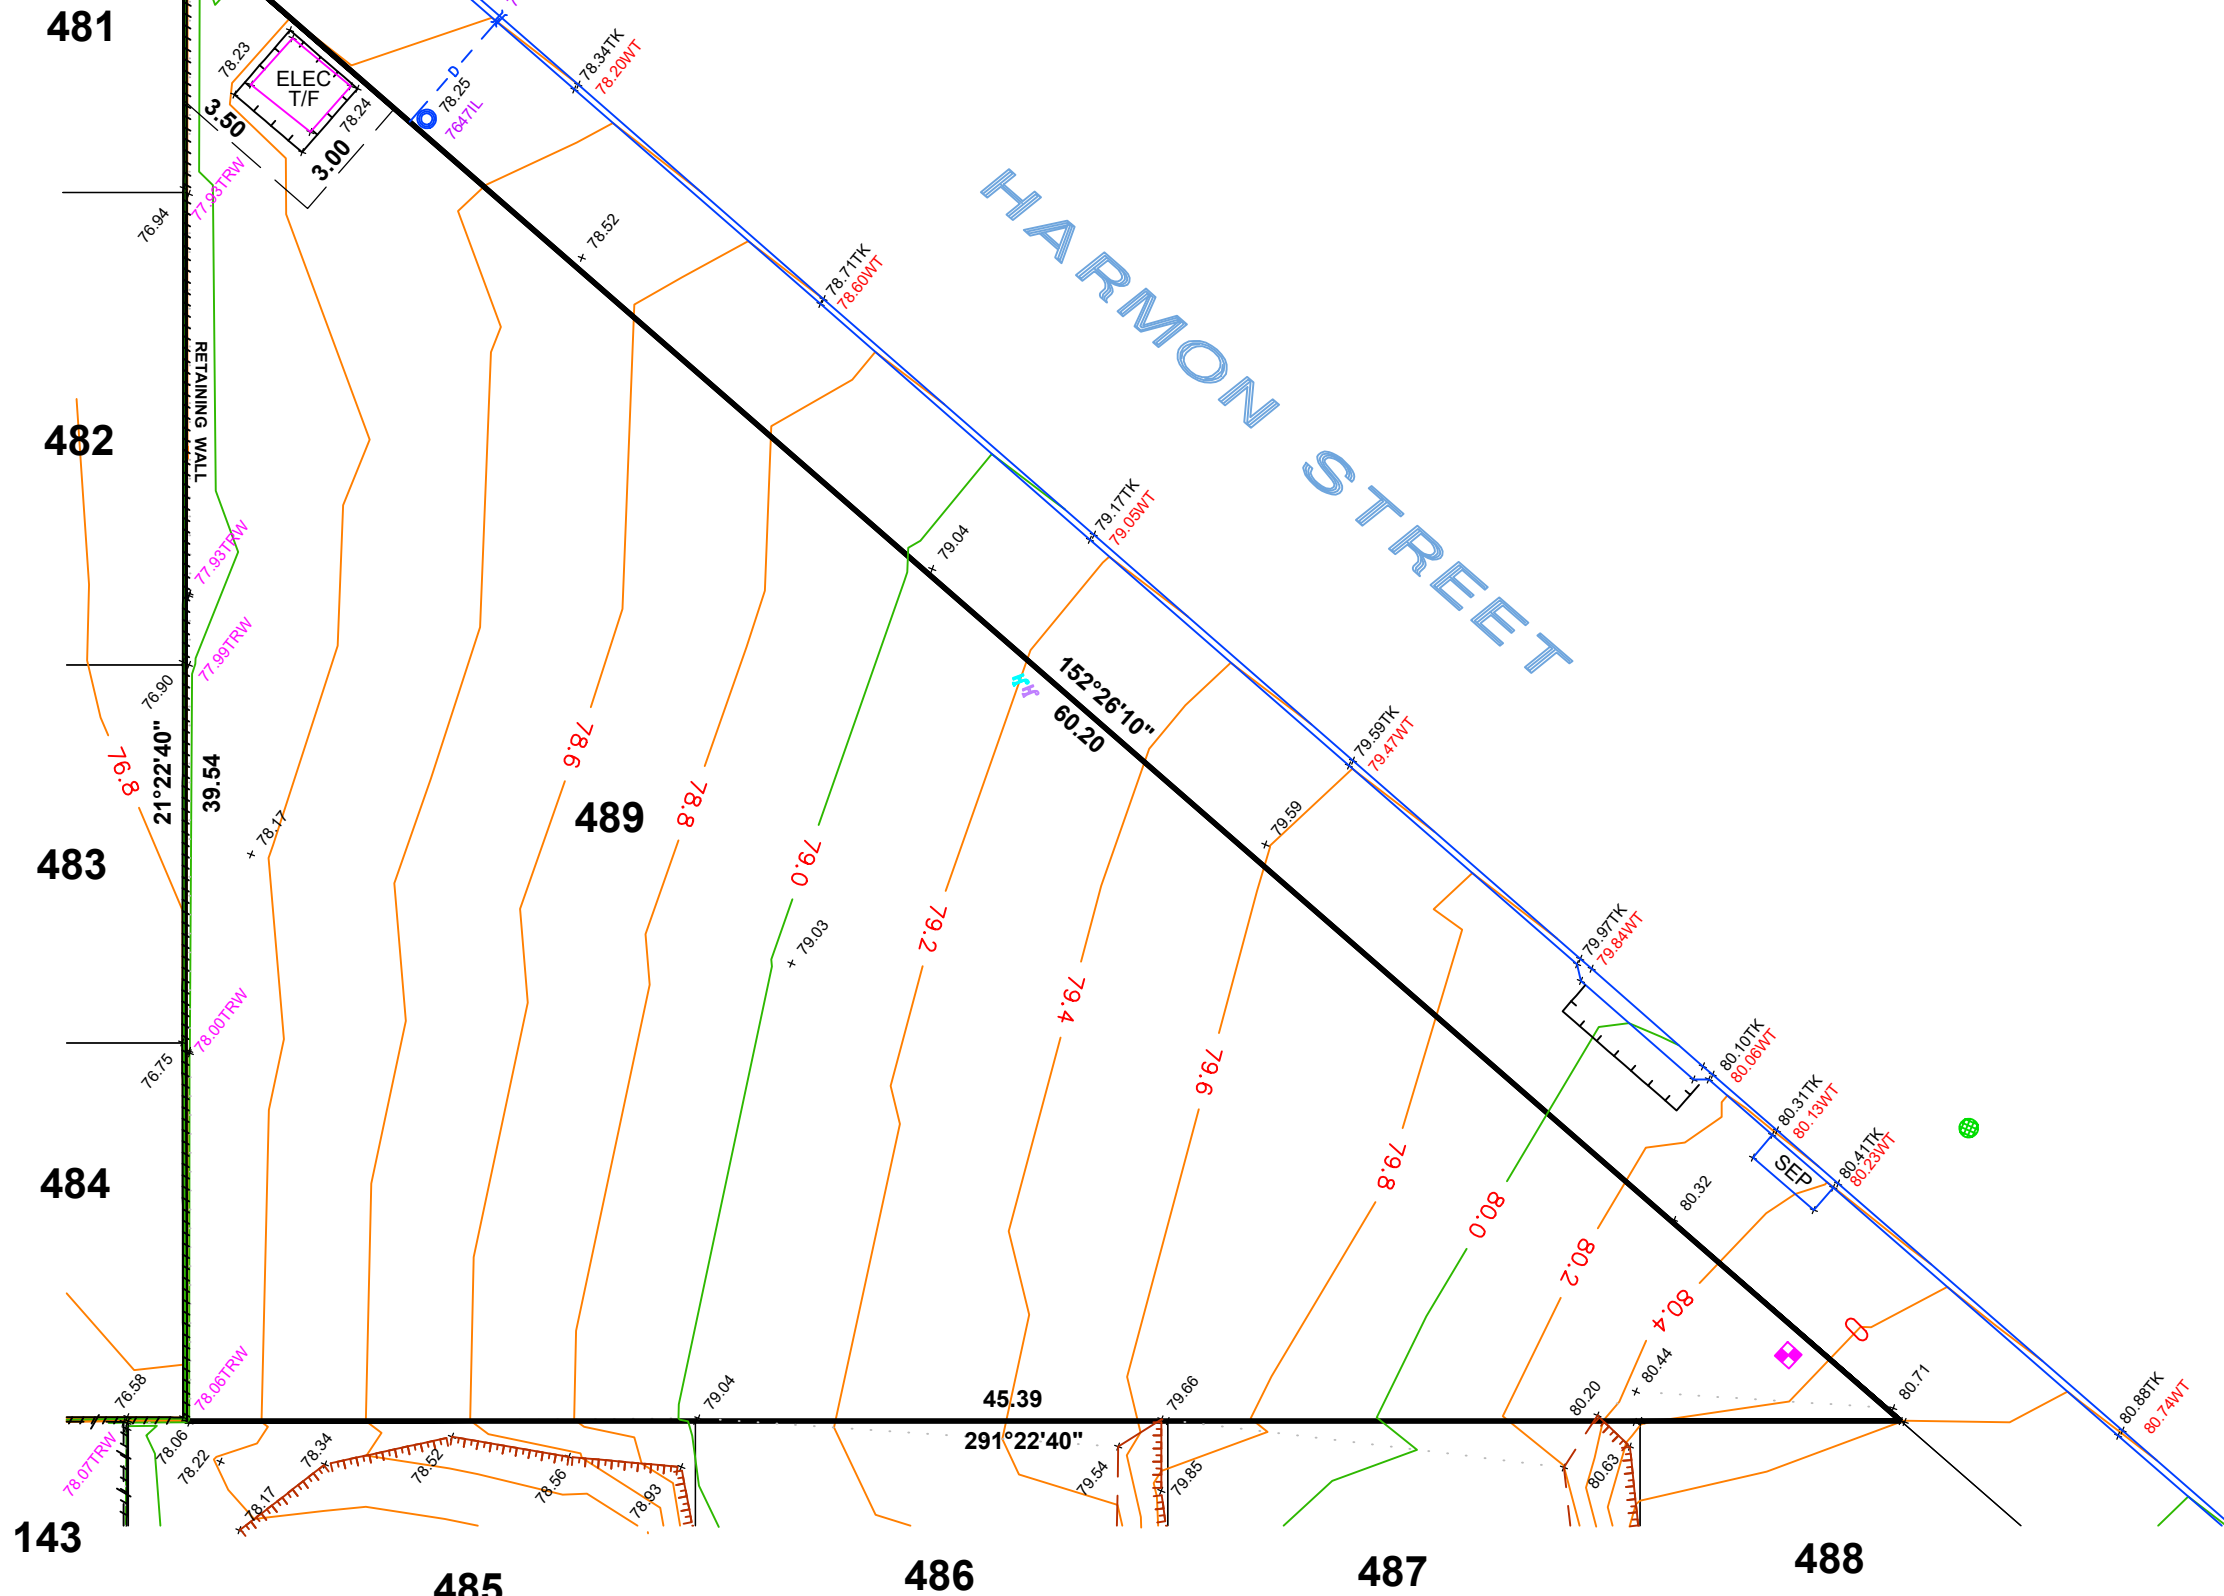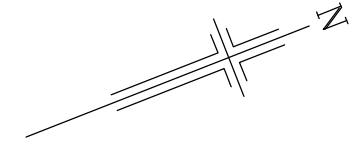


- LEGEND**
- WATER METER
  - SEWER IP
  - STOBIE POLE
  - TELSTRA PIT
  - S/W GRATING
  - SEWER MAN HOLE
  - S/W MANHOLE
  - LIGHT POLE
  - ETSA CONNECTION
  - TAP
  - BOLLARD
  - SIGN
  - S/W CONNECTION
  - FOOTPATH
  - SIDE ENTRY PIT
  - COMMON SERVICE TRENCH
  - DOMESTIC
  - SEWER IO
  - POTABLE WATER CONN
  - NON-POTABLE WATER CONN
  - TOP RETAINING WALL




SCALE 1:200

**ALLOTMENT 491 in DEV. NO. 145/D215/12/007**  
**in the area named**  
**SEAFORD HEIGHTS**  
 CT ---/----  
**AS CONSTRUCTED**

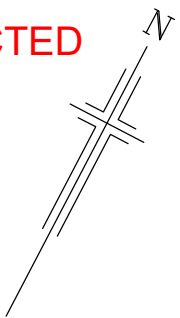

**HARMON STREET**

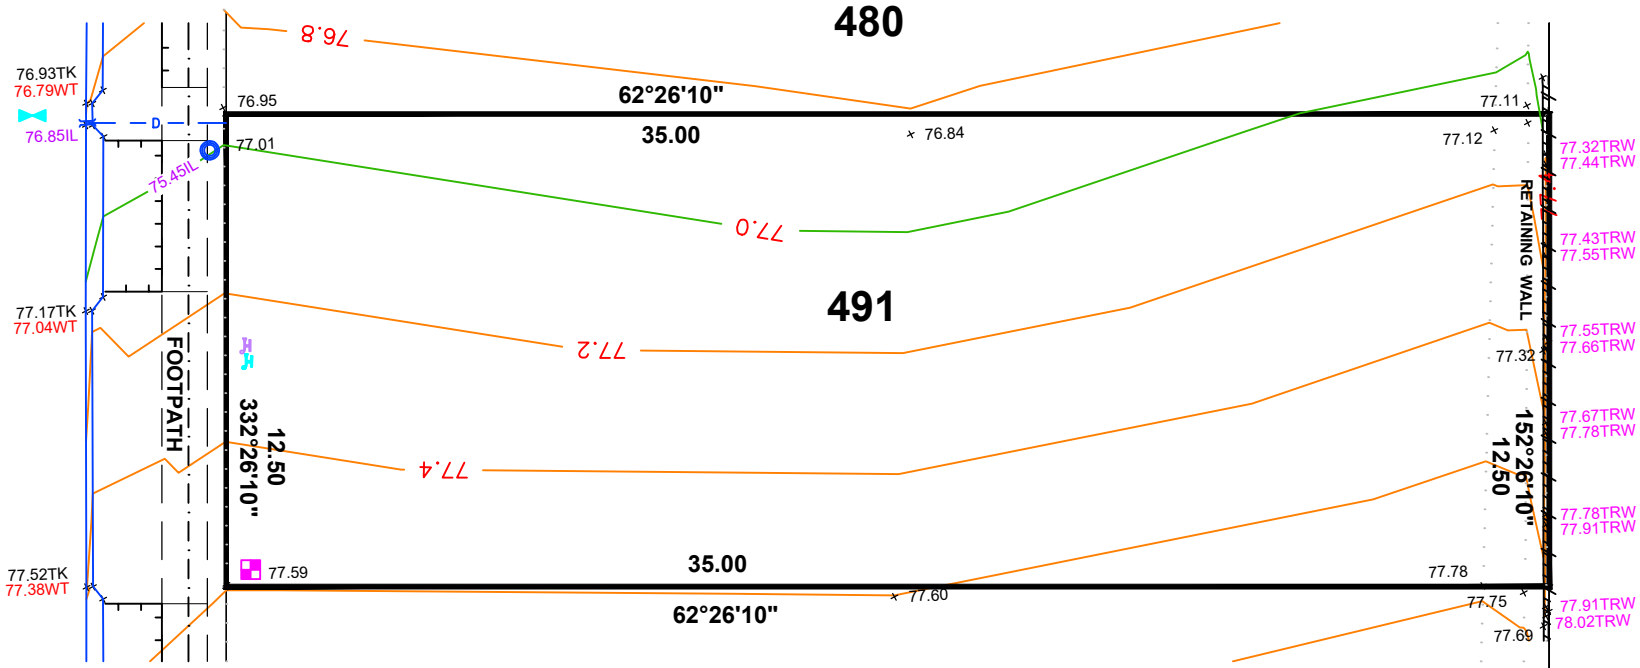

- LEGEND**
- WATER METER
  - SEWER IP
  - STOBIE POLE
  - TELSTRA PIT
  - S/W GRATING
  - SEWER MAN HOLE
  - S/W MANHOLE
  - LIGHT POLE
  - ETSA CONNECTION
  - TAP
  - BOLLARD
  - SIGN
  - S/W CONNECTION
  - CONCRETE
  - FOOTPATH
  - SIDE ENTRY PIT
  - COMMON SERVICE TRENCH
  - DOMESTIC
  - SEWER IO
  - POTABLE WATER CONN
  - NON-POTABLE WATER CONN
  - 29.00TRW TOP RETAINING WALL
  - 29.00IL INVERT LEVEL




**1:200**

NOTE: FOOTPATH & CST DATA SHOWN HEREON IS DESIGN INFORMATION AND SHOULD BE CONFIRMED


ORIGINAL SHEET SIZE A4

**ALEXANDER SYMONDS**  
 PH 8130 1666

**ALLOTMENT 492 in DEV. NO. 145/D215/12/007**  
**in the area named**  
**SEAFORD HEIGHTS**  
 CT ---/----  
**AS CONSTRUCTED**

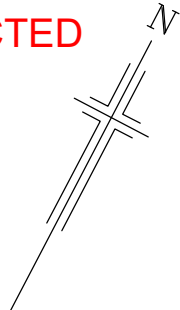

**HARMON STREET**

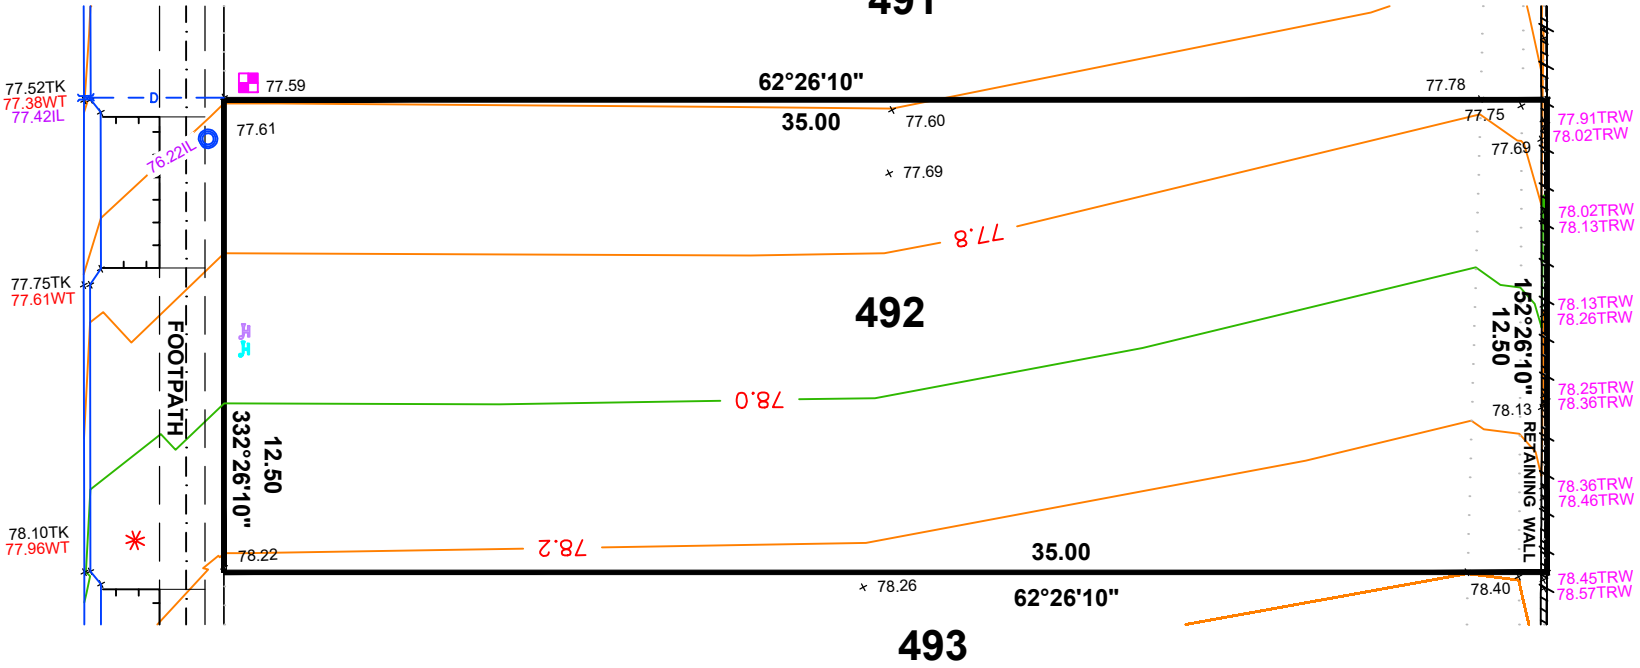

- LEGEND**
- WATER METER
  - SEWER IP
  - STOBIE POLE
  - TELSTRA PIT
  - S/W GRATING
  - SEWER MAN HOLE
  - S/W MANHOLE
  - LIGHT POLE
  - ETSA CONNECTION
  - TAP
  - BOLLARD
  - SIGN
  - S/W CONNECTION
  - CONCRETE
  - FOOTPATH
  - SIDE ENTRY PIT
  - COMMON SERVICE TRENCH
  - DOMESTIC
  - SEWER IO
  - POTABLE WATER CONN
  - NON-POTABLE WATER CONN
  - 29.00TRW TOP RETAINING WALL
  - 29.00IL INVERT LEVEL




**1:200**

**ALEXANDER SYMONDS**  
PH 8130 1666


NOTE: FOOTPATH & CST DATA SHOWN HEREON IS DESIGN INFORMATION AND SHOULD BE CONFIRMED  
 ORIGINAL SHEET SIZE A4



**ALLOTMENT 493 in DEV. NO. 145/D215/12/007**  
in the area named  
**SEAFORD HEIGHTS**  
CT ---/----  
**AS CONSTRUCTED**

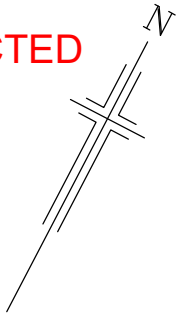

**HARMON STREET**

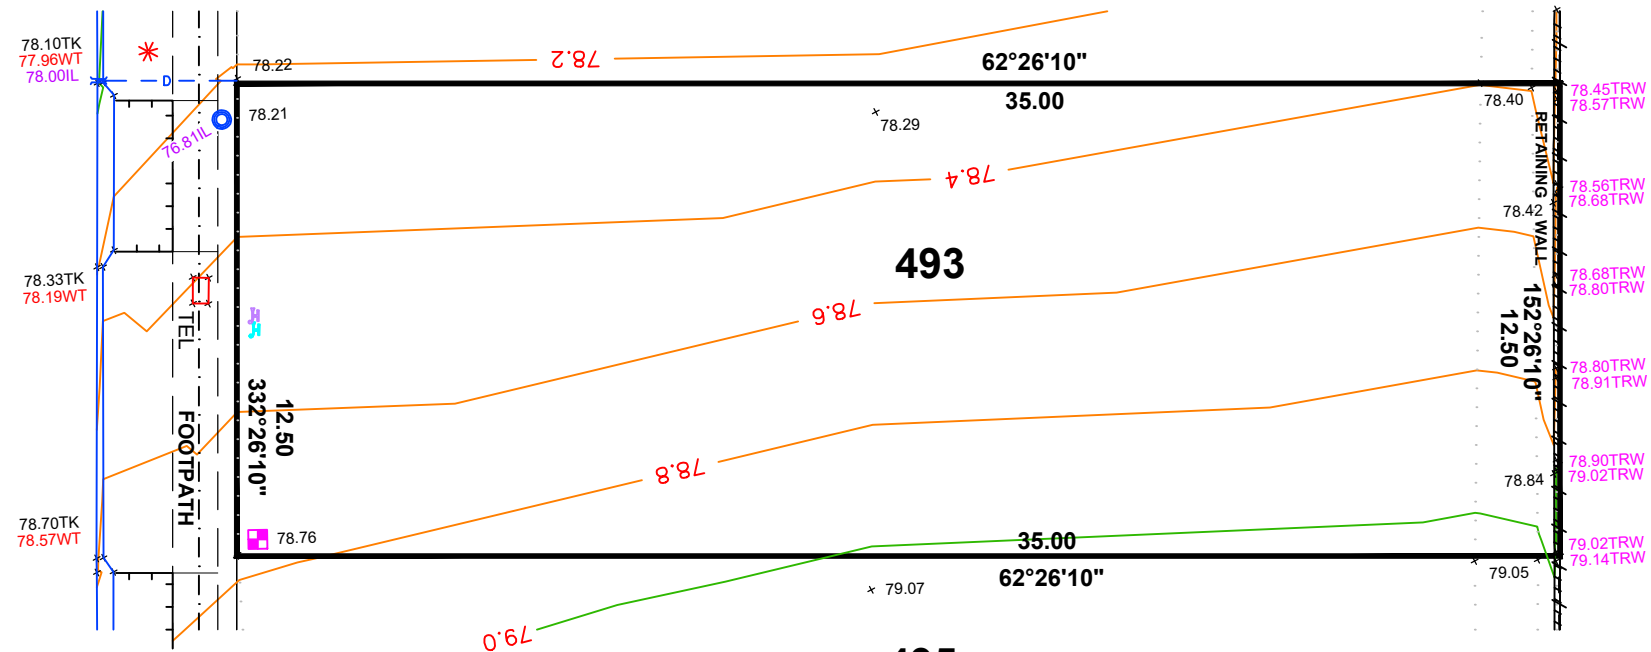

- LEGEND**
- WATER METER
  - SEWER IP
  - STOBIE POLE
  - TELSTRA PIT
  - S/W GRATING
  - SEWER MAN HOLE
  - S/W MANHOLE
  - LIGHT POLE
  - ETSA CONNECTION
  - TAP
  - BOLLARD
  - SIGN
  - S/W CONNECTION
  - CONCRETE
  - FOOTPATH
  - SIDE ENTRY PIT
  - COMMON SERVICE TRENCH
  - DOMESTIC
  - SEWER IO
  - POTABLE WATER CONN
  - NON-POTABLE WATER CONN
  - TOP RETAINING WALL
  - INVERT LEVEL




**1:200**

NOTE: FOOTPATH & CST DATA SHOWN HEREON IS DESIGN INFORMATION AND SHOULD BE CONFIRMED


ORIGINAL SHEET SIZE A4

**ALEXANDER SYMONDS**  
PH 8130 1666

**ALLOTMENT 495 in DEV. NO. 145/D215/12/007**  
in the area named  
**SEAFORD HEIGHTS**  
CT ---/----  
**AS CONSTRUCTED**

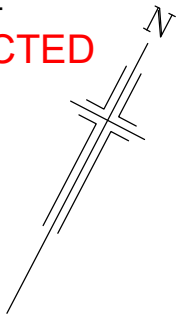

**HARMON STREET**

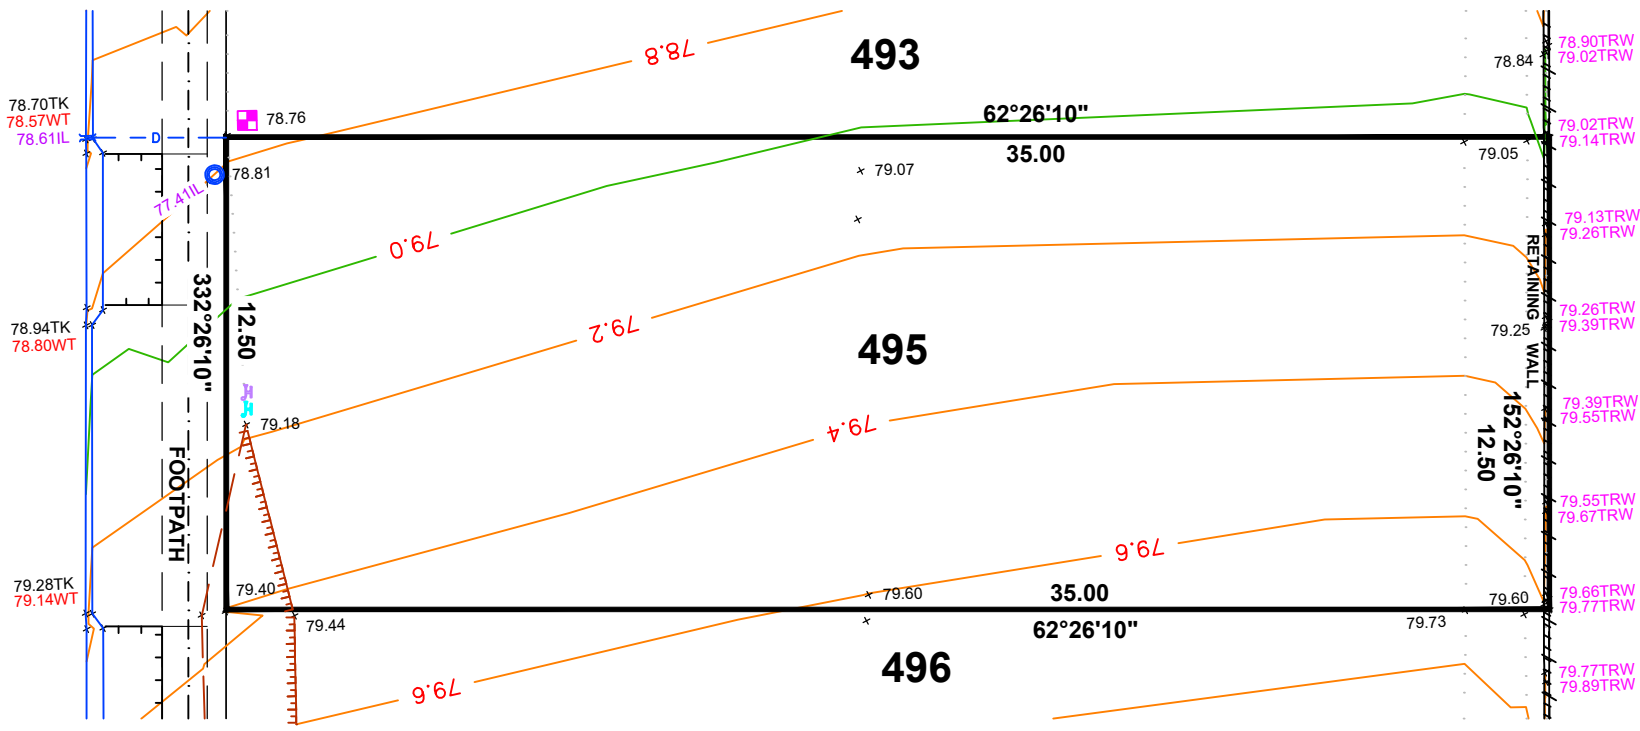

- LEGEND**
- WATER METER
  - SEWER IP
  - STOBIE POLE
  - TELSTRA PIT
  - S/W GRATING
  - SEWER MAN HOLE
  - S/W MANHOLE
  - LIGHT POLE
  - ETSA CONNECTION
  - TAP
  - BOLLARD
  - SIGN
  - S/W CONNECTION
  - CONCRETE
  - FOOTPATH
  - SIDE ENTRY PIT
  - COMMON SERVICE TRENCH
  - DOMESTIC
  - SEWER IO
  - POTABLE WATER CONN
  - NON-POTABLE WATER CONN
  - 29.00TRW
  - 29.00IL




**1:200**

NOTE: FOOTPATH & CST DATA SHOWN HEREON IS DESIGN INFORMATION AND SHOULD BE CONFIRMED


ORIGINAL SHEET SIZE A4

**ALEXANDER SYMONDS**  
**PH 8130 1666**

**ALLOTMENT 496 in DEV. NO. 145/D215/12/007**  
**in the area named**  
**SEAFORD HEIGHTS**  
 CT ---/----  
**AS CONSTRUCTED**

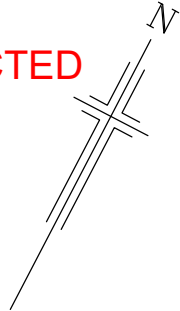

**HARMON STREET**

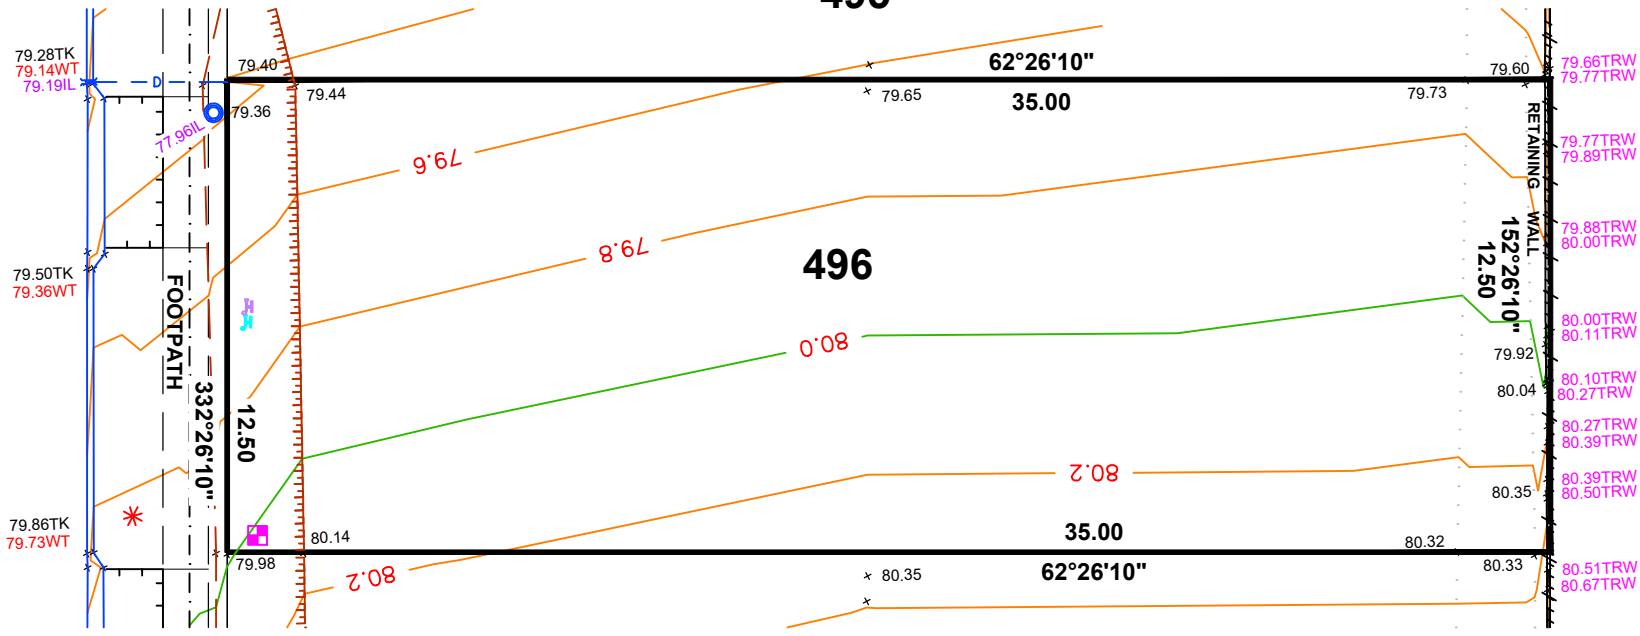

- LEGEND**
- WATER METER
  - SEWER IP
  - STOBIE POLE
  - TELSTRA PIT
  - S/W GRATING
  - SEWER MAN HOLE
  - S/W MANHOLE
  - LIGHT POLE
  - ETSA CONNECTION
  - TAP
  - BOLLARD
  - SIGN
  - S/W CONNECTION
  - CONCRETE
  - FOOTPATH
  - SIDE ENTRY PIT
  - COMMON SERVICE TRENCH
  - DOMESTIC
  - SEWER IO
  - POTABLE WATER CONN
  - NON-POTABLE WATER CONN
  - 29.00TRW TOP RETAINING WALL
  - 29.00IL INVERT LEVEL




**1:200**

NOTE: FOOTPATH & CST DATA SHOWN HEREON IS DESIGN INFORMATION AND SHOULD BE CONFIRMED


ORIGINAL SHEET SIZE A4

**ALEXANDER SYMONDS**  
 PH 8130 1666

**ALLOTMENT 497 in DEV. NO. 145/D215/12/007**  
**in the area named**  
**SEAFORD HEIGHTS**  
 CT ---/----  
**AS CONSTRUCTED**

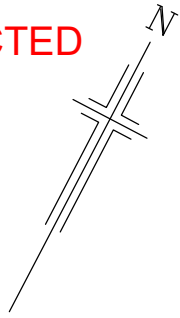

**HARMON STREET**

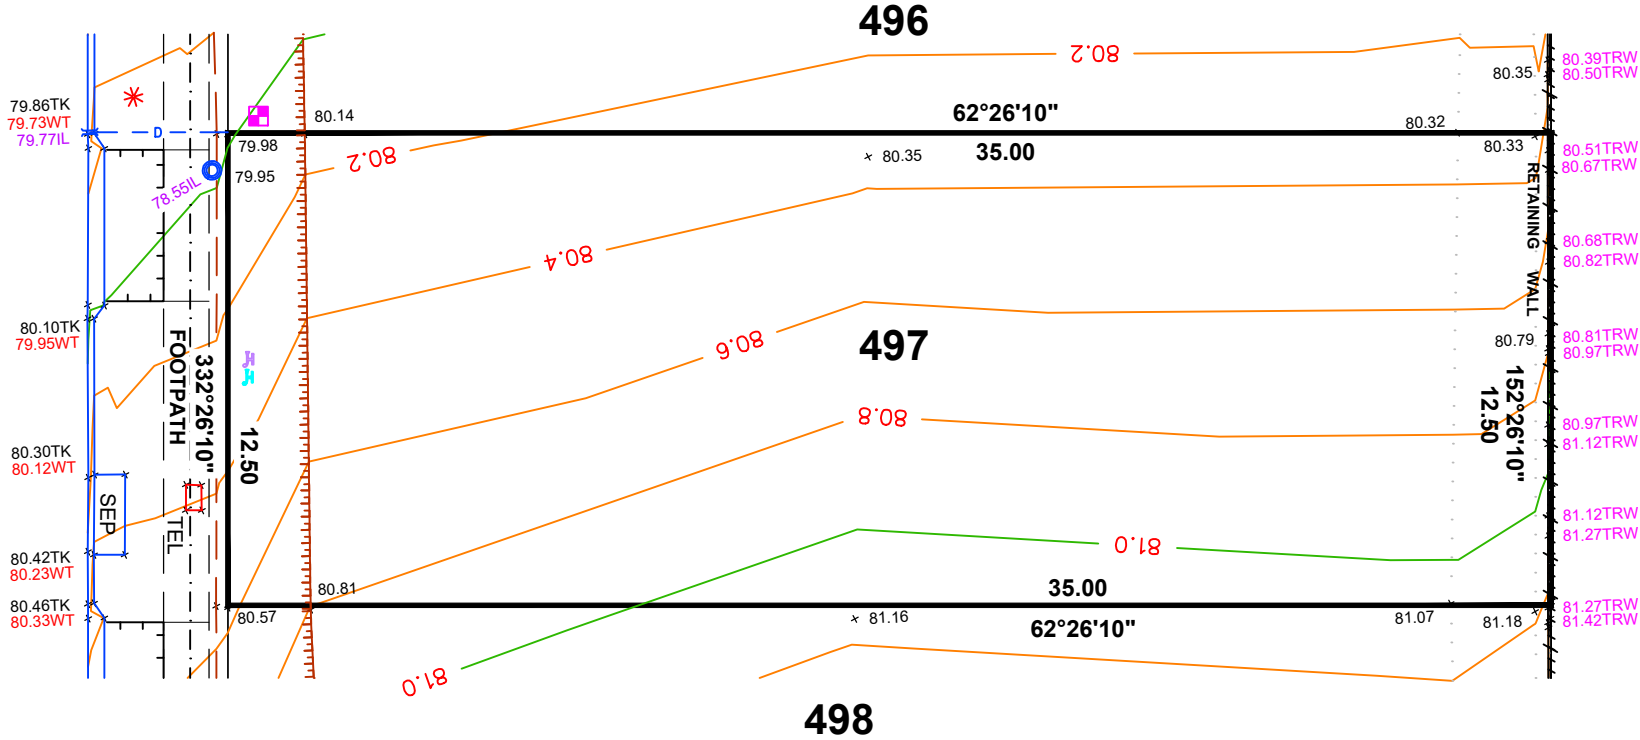

- LEGEND**
- WATER METER
  - SEWER IP
  - STOBIE POLE
  - TELSTRA PIT
  - S/W GRATING
  - SEWER MAN HOLE
  - S/W MANHOLE
  - LIGHT POLE
  - E.T.S.A CONNECTION
  - TAP
  - BOLLARD
  - SIGN
  - S/W CONNECTION
  - CONCRETE
  - FOOTPATH
  - SIDE ENTRY PIT
  - COMMON SERVICE TRENCH
  - DOMESTIC
  - SEWER IO
  - POTABLE WATER CONN
  - NON-POTABLE WATER CONN
  - 29.00TRW TOP RETAINING WALL
  - 29.00IL INVERT LEVEL



**1:200**


NOTE: FOOTPATH & CST DATA SHOWN HEREON IS DESIGN INFORMATION AND SHOULD BE CONFIRMED

ORIGINAL SHEET SIZE A4


**ALEXANDER SYMONDS**  
 PH 8130 1666

**ALLOTMENT 498 in DEV. NO. 145/D215/12/007**  
in the area named  
**SEAFORD HEIGHTS**

CT ---/----  
**AS CONSTRUCTED**

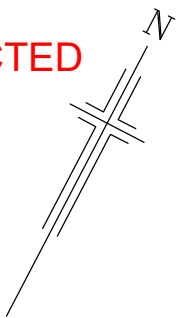

**HARMON STREET**

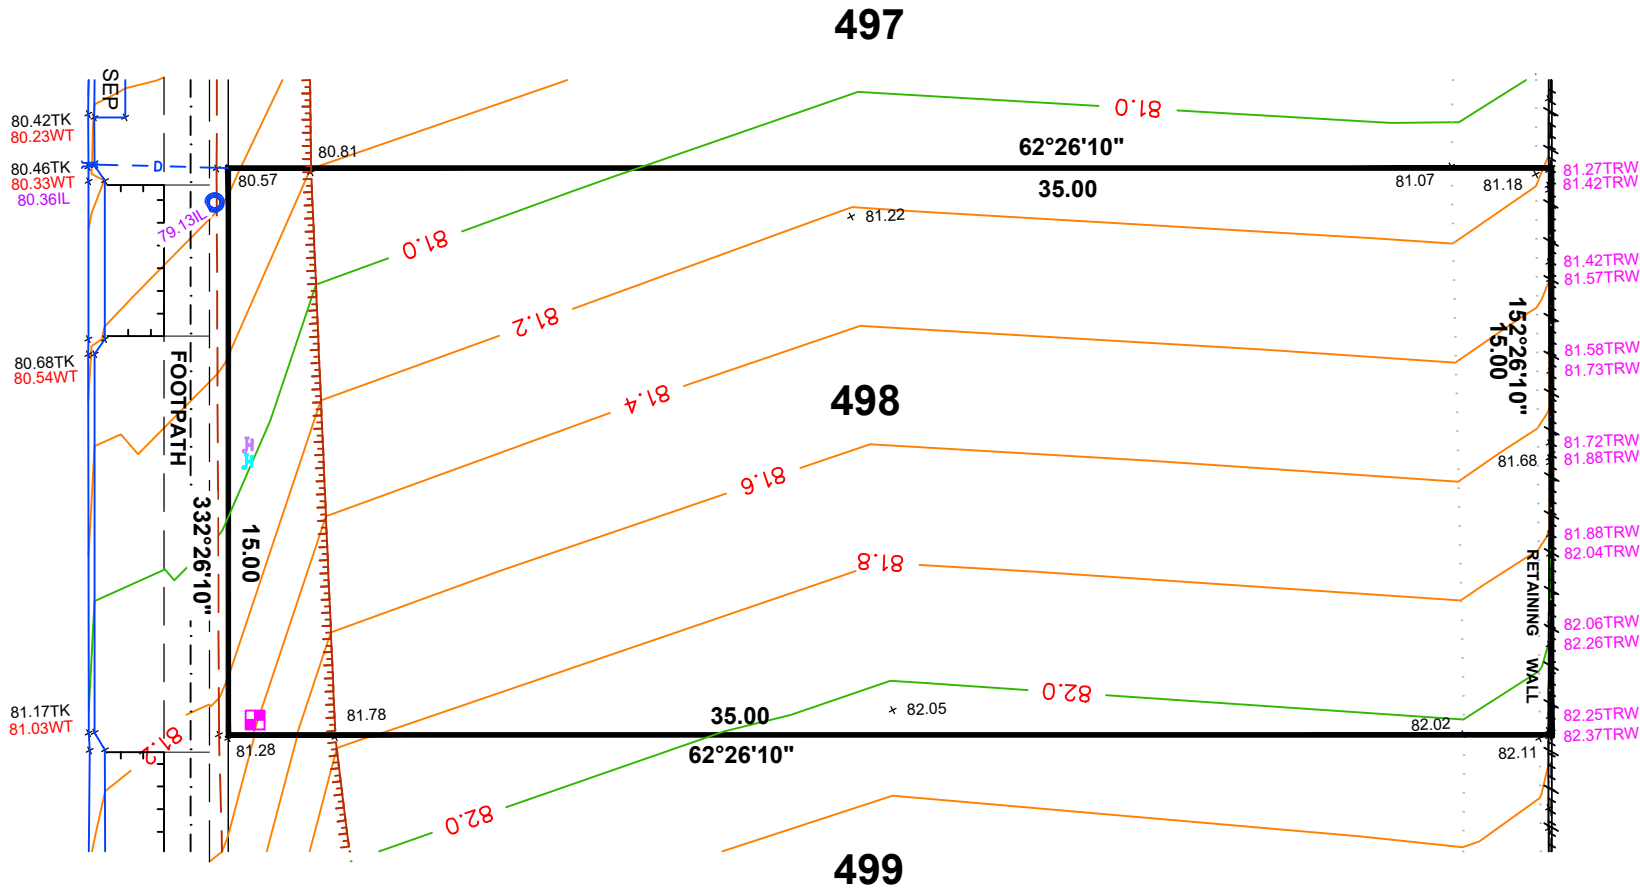

- LEGEND**
- WATER METER
  - SEWER IP
  - STOBIE POLE
  - TELSTRA PIT
  - S/W GRATING
  - SEWER MAN HOLE
  - S/W MANHOLE
  - LIGHT POLE
  - ETSA CONNECTION
  - TAP
  - BOLLARD
  - SIGN
  - S/W CONNECTION
  - CONCRETE
  - FOOTPATH
  - SIDE ENTRY PIT
  - COMMON SERVICE TRENCH
  - DOMESTIC
  - SEWER IO
  - POTABLE WATER CONN
  - NON-POTABLE WATER CONN
  - 29.00TRW TOP RETAINING WALL
  - 29.00IL INVERT LEVEL




**1:200**


NOTE: FOOTPATH & CST DATA SHOWN HEREON IS DESIGN INFORMATION AND SHOULD BE CONFIRMED  
ORIGINAL SHEET SIZE A4

ALEXANDER SYMONDS  
PH 8130 1666

**ALLOTMENT 499 in DEV. NO. 145/D215/12/007**  
in the area named  
**SEAFORD HEIGHTS**  
CT ---/---  
**AS CONSTRUCTED**

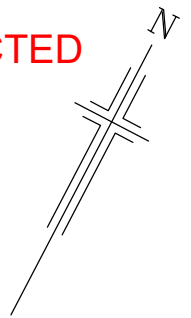

**HARMON STREET**

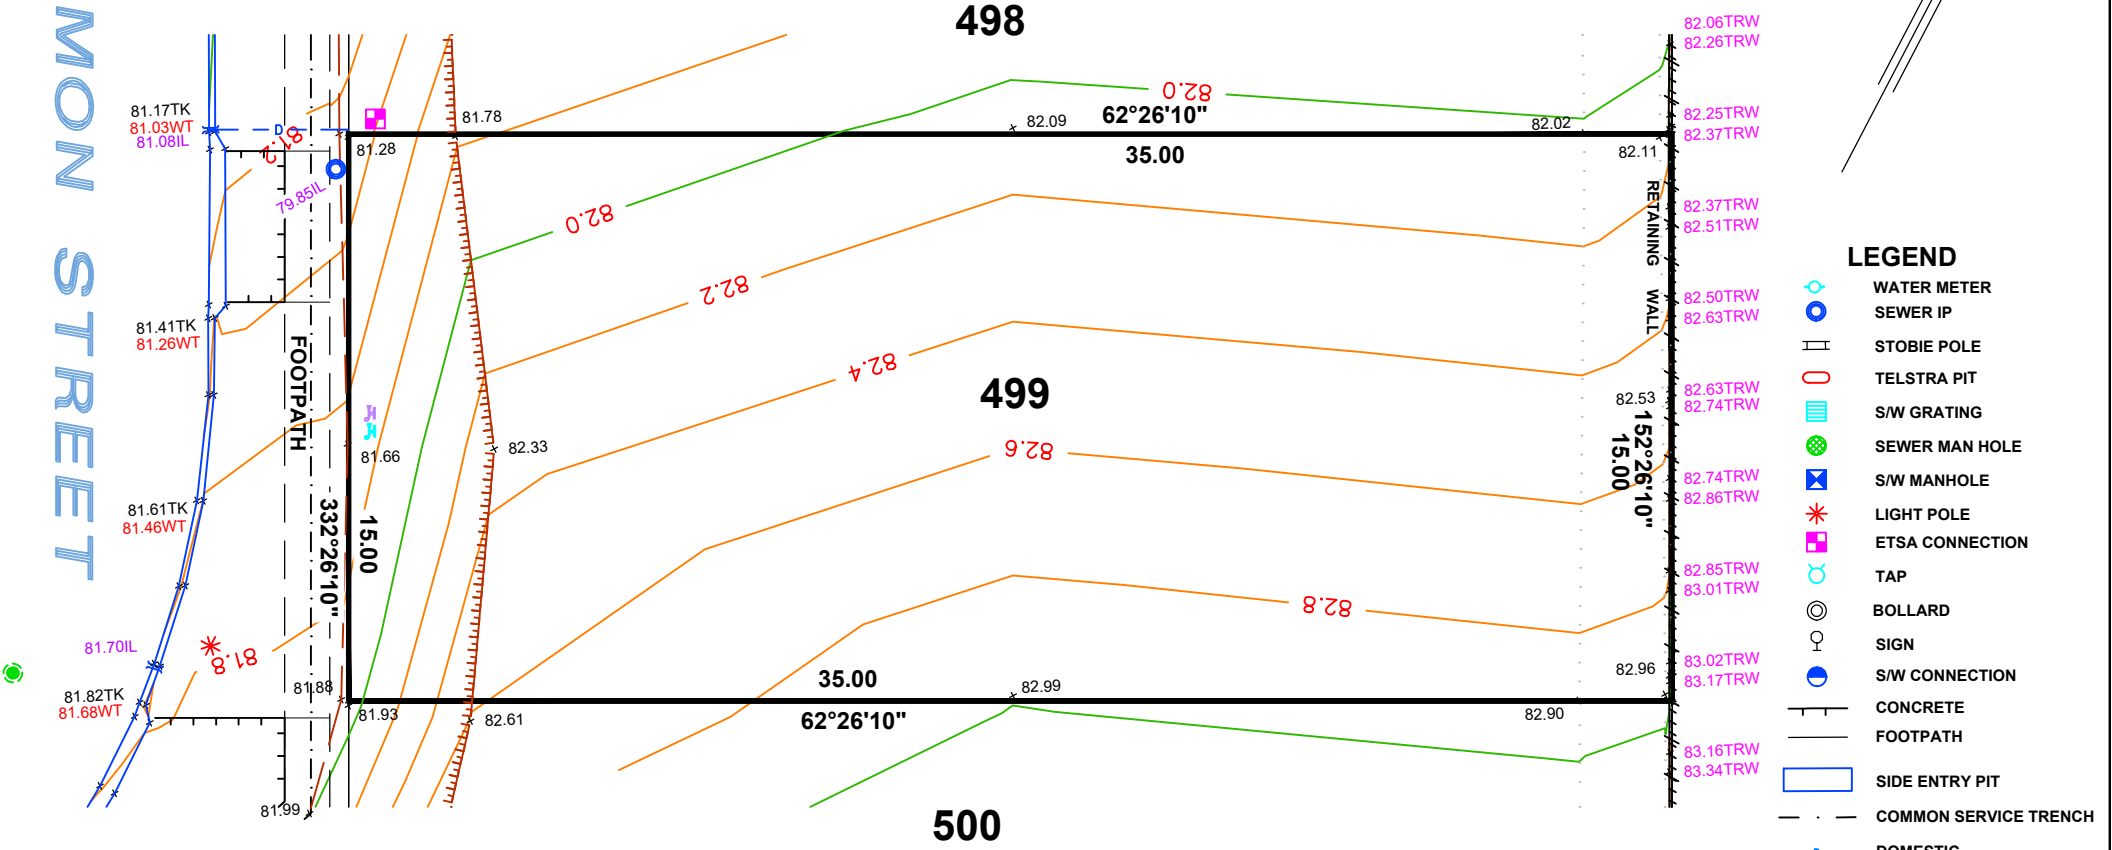

- LEGEND**
- WATER METER
  - SEWER IP
  - STOBIE POLE
  - TELSTRA PIT
  - S/W GRATING
  - SEWER MAN HOLE
  - S/W MANHOLE
  - LIGHT POLE
  - ETSA CONNECTION
  - TAP
  - BOLLARD
  - SIGN
  - S/W CONNECTION
  - CONCRETE
  - FOOTPATH
  - SIDE ENTRY PIT
  - COMMON SERVICE TRENCH
  - DOMESTIC
  - SEWER IO
  - POTABLE WATER CONN
  - NON-POTABLE WATER CONN
  - 29.00TRW TOP RETAINING WALL
  - 29.00IL INVERT LEVEL





**1:200**

**ALEXANDER SYMONDS**  
PH 8130 1666

NOTE: FOOTPATH & CST DATA SHOWN HEREON IS DESIGN INFORMATION AND SHOULD BE CONFIRMED  
ORIGINAL SHEET SIZE A4

ALLOTMENT 500 in DEV. NO. 145/D215/12/007  
in the area named  
**SEAFORD HEIGHTS**  
CT ---/---


**AS CONSTRUCTED**

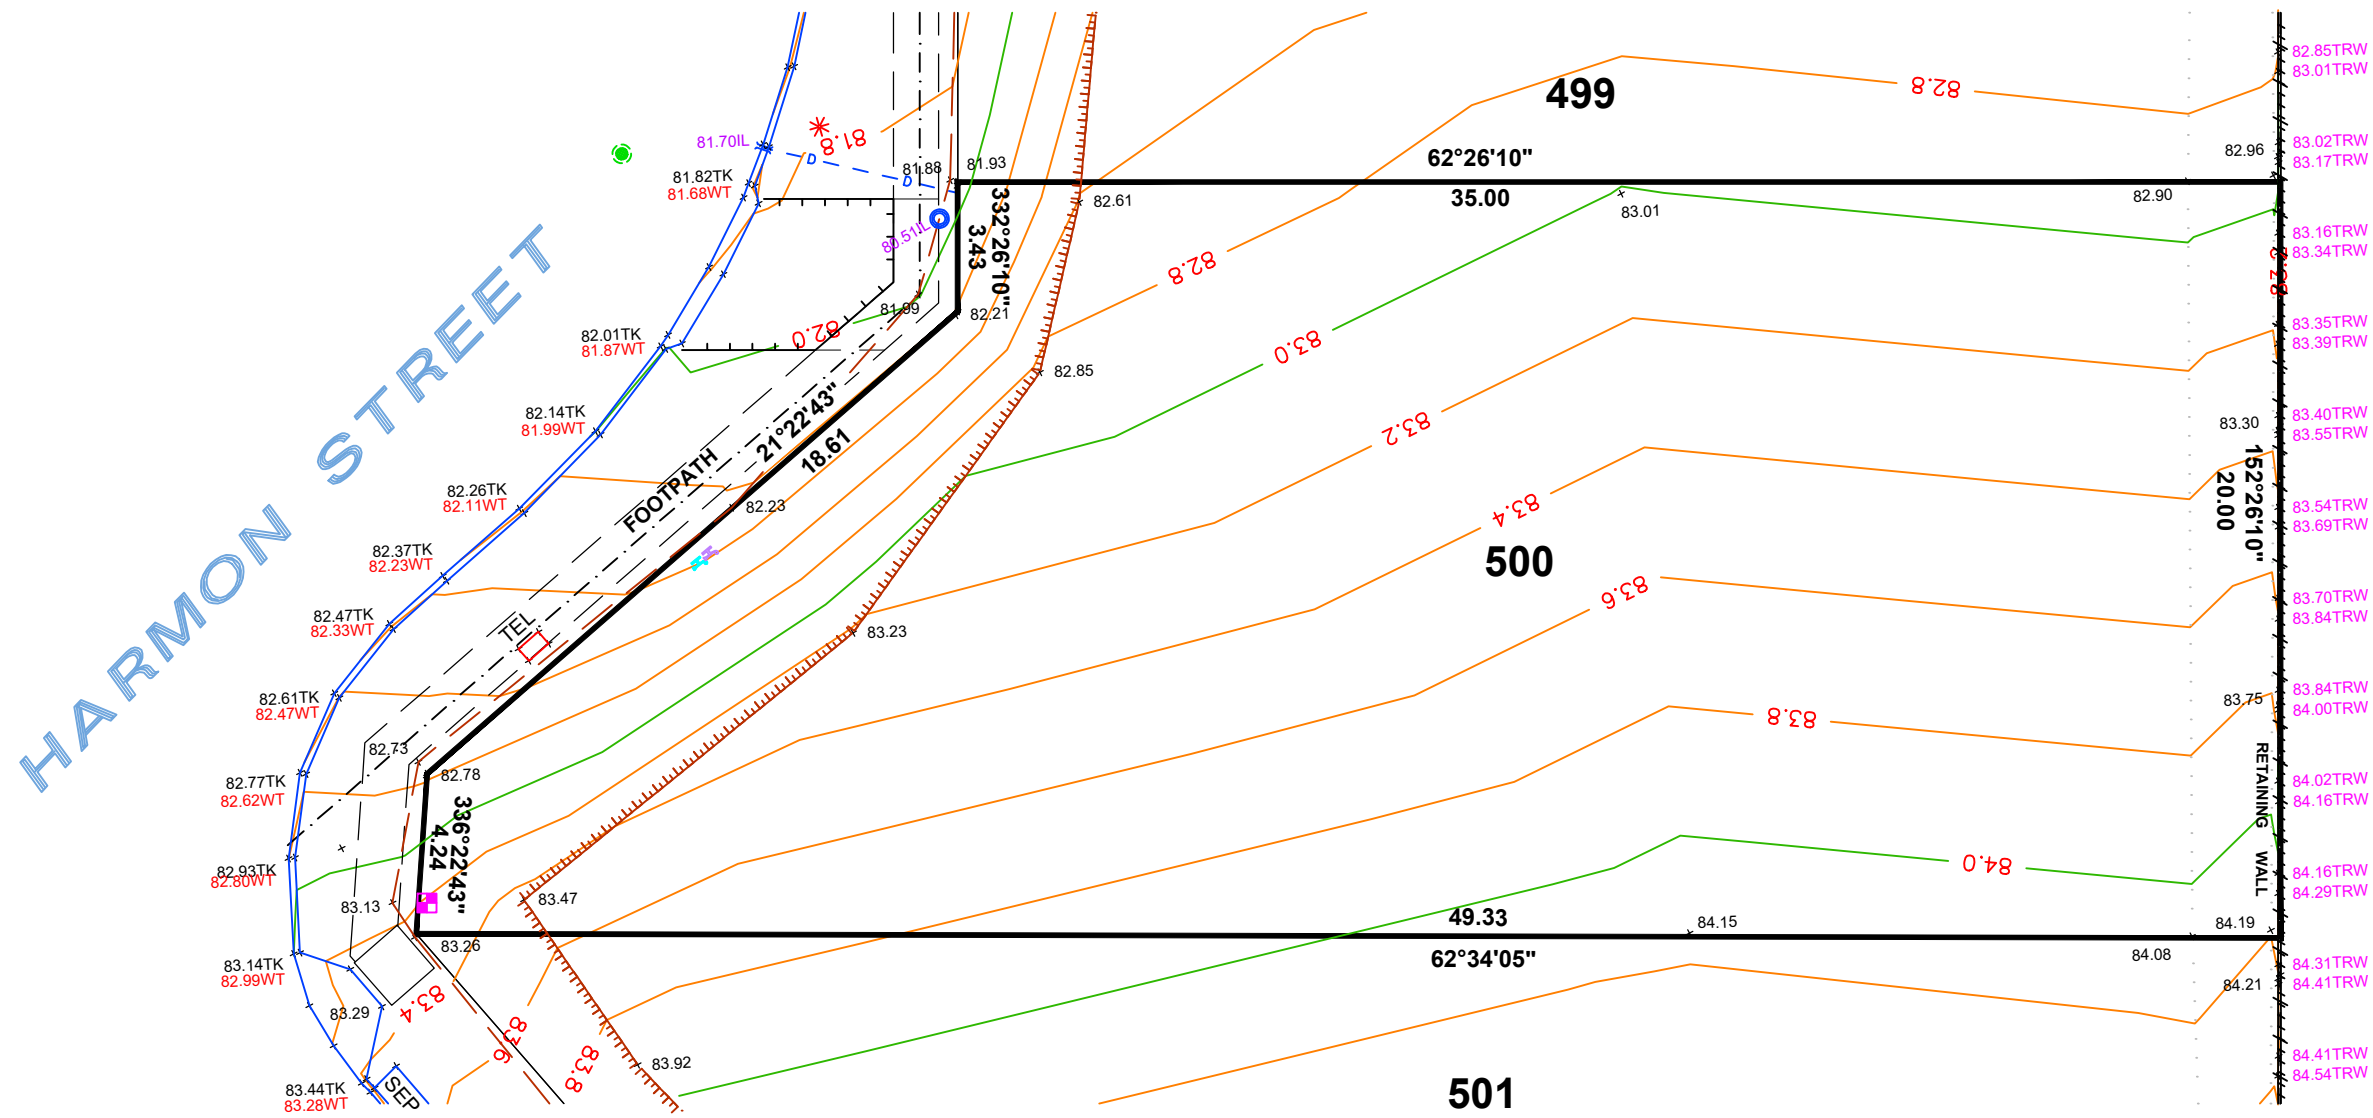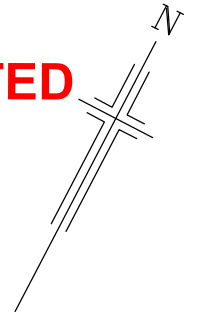

- LEGEND**
- WATER METER
  - SEWER IP
  - STOBIE POLE
  - TELSTRA PIT
  - S/W GRATING
  - SEWER MAN HOLE
  - S/W MANHOLE
  - LIGHT POLE
  - ETSA CONNECTION
  - TAP
  - BOLLARD
  - SIGN
  - S/W CONNECTION
  - CONCRETE
  - FOOTPATH
  - SIDE ENTRY PIT
  - COMMON SERVICE TRENCH
  - DOMESTIC
  - SEWER IO
  - POTABLE WATER CONN
  - NON-POTABLE WATER CONN
  - TOP RETAINING WALL
  - INVERT LEVEL

NOTE: FOOTPATH & CST DATA SHOWN HEREON IS DESIGN INFORMATION AND SHOULD BE CONFIRMED.



ALEXANDER SYMONDS  
PH 8130 1666

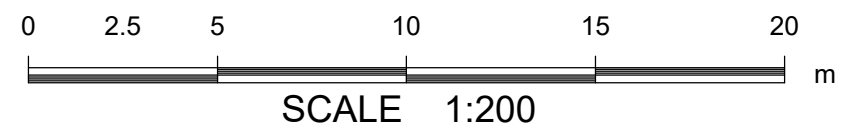

ORIGINAL SHEET SIZE A3

ALLOTMENT 501 in DEV. NO. 145/D215/12/007  
in the area named  
**SEAFORD HEIGHTS**  
CT ---/---

**AS CONSTRUCTED**

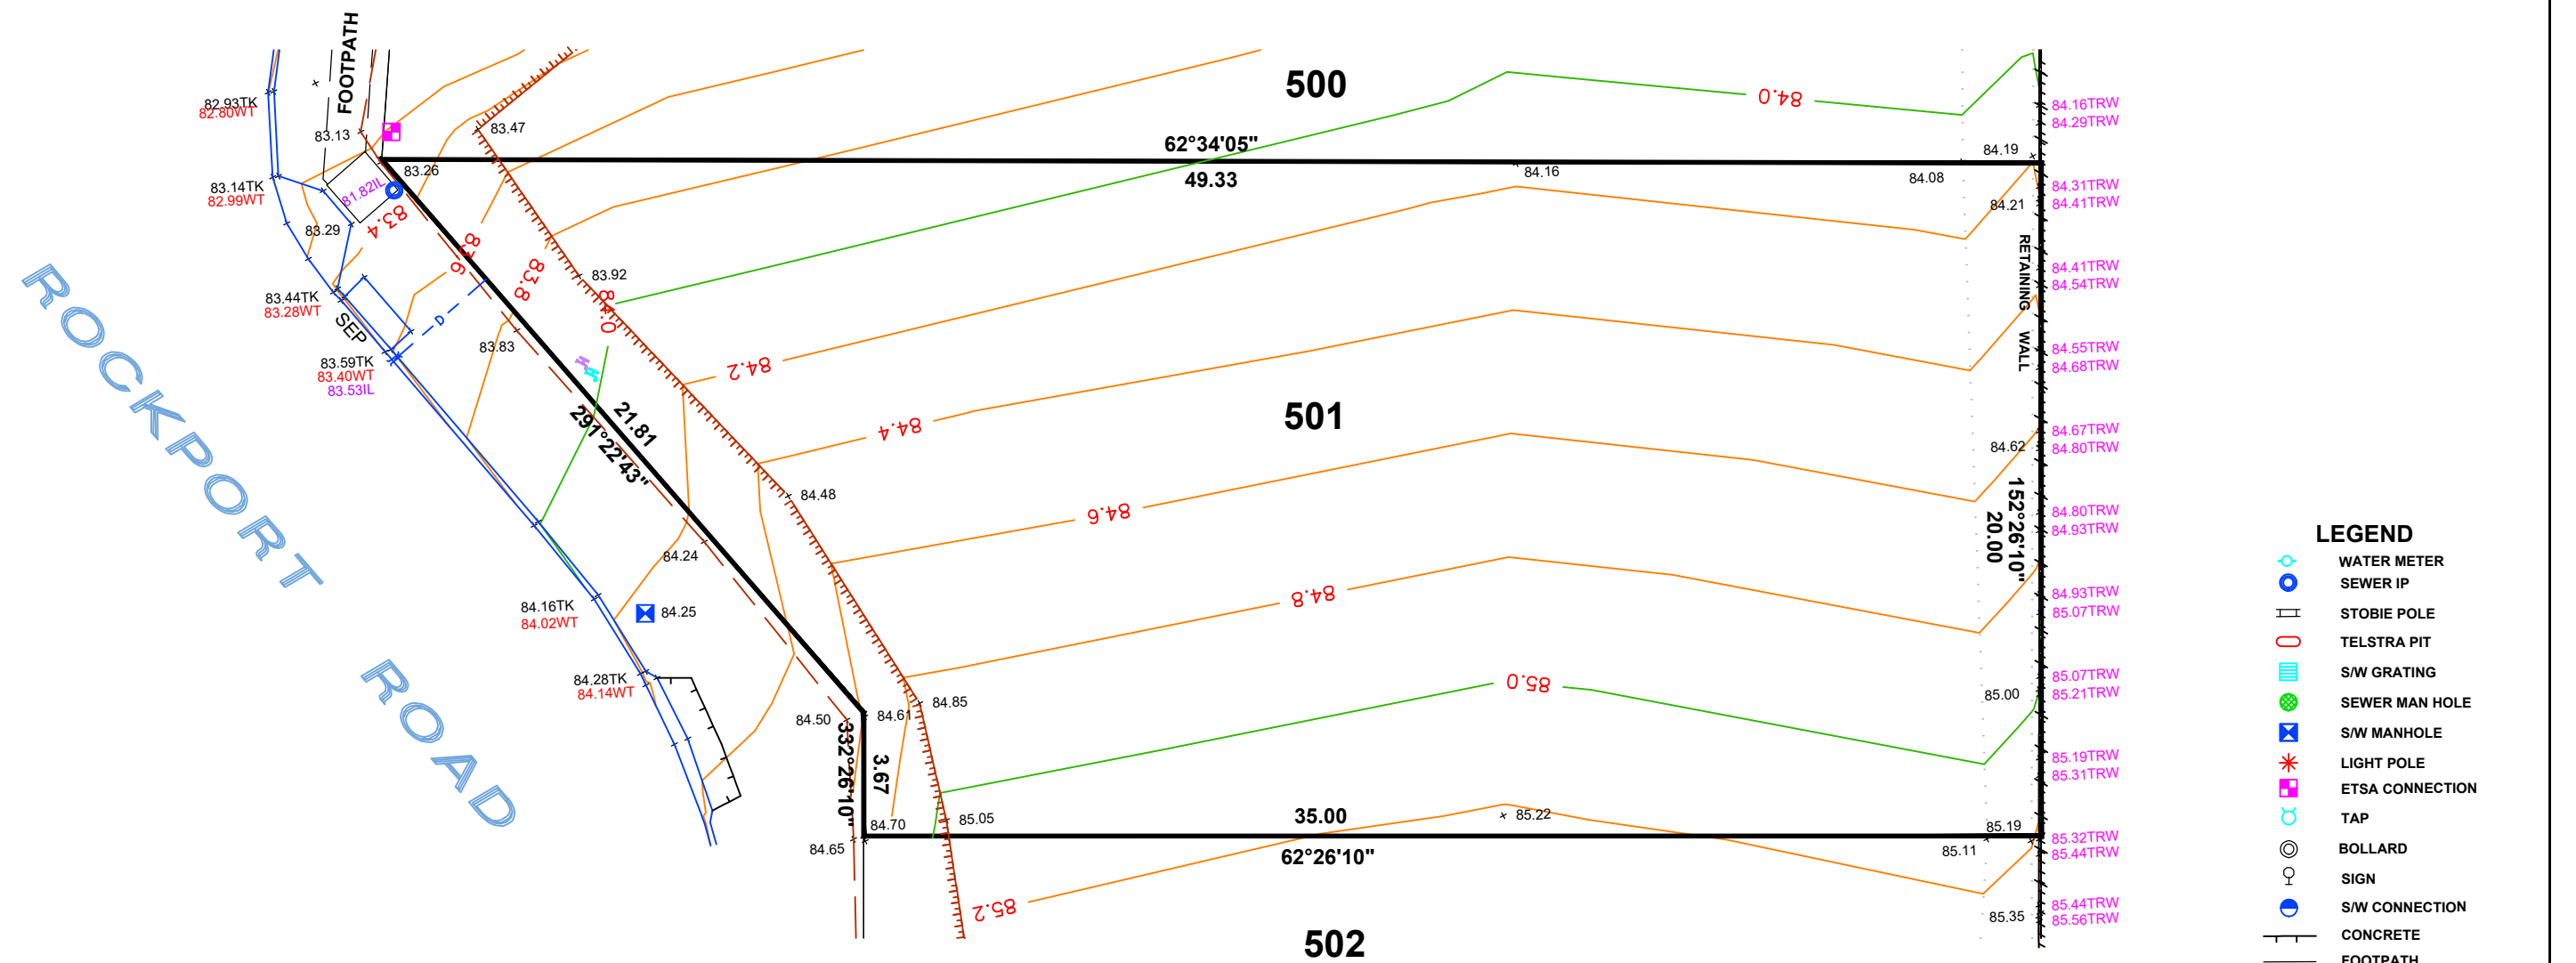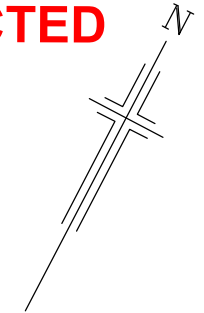


**LEGEND**

- WATER METER
- SEWER IP
- STOBIE POLE
- TELSTRA PIT
- S/W GRATING
- SEWER MAN HOLE
- S/W MANHOLE
- LIGHT POLE
- ETSA CONNECTION
- TAP
- BOLLARD
- SIGN
- S/W CONNECTION
- CONCRETE
- FOOTPATH
- SIDE ENTRY PIT
- COMMON SERVICE TRENCH
- DOMESTIC
- SEWER IO
- POTABLE WATER CONN
- NON-POTABLE WATER CONN
- TOP RETAINING WALL
- INVERT LEVEL

NOTE: FOOTPATH & CST DATA SHOWN HEREON IS DESIGN INFORMATION AND SHOULD BE CONFIRMED.

ALEXANDER SYMONDS  
PH 8130 1666

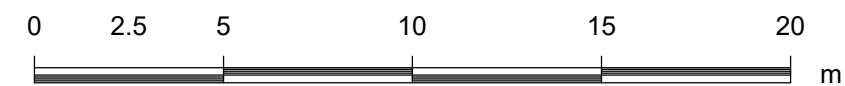

SCALE 1:200

ORIGINAL SHEET SIZE A3