

DISCLAIMER:


Please note that this site plan is intended for visual purposes only, additional survey work will be required prior to commencing any design or construction on the site.

ALLOTMENT 472 in DEV. NO. 145/D215/12/007

in the area named
SEAFORD HEIGHTS

CT ---/----

AS CONSTRUCTED

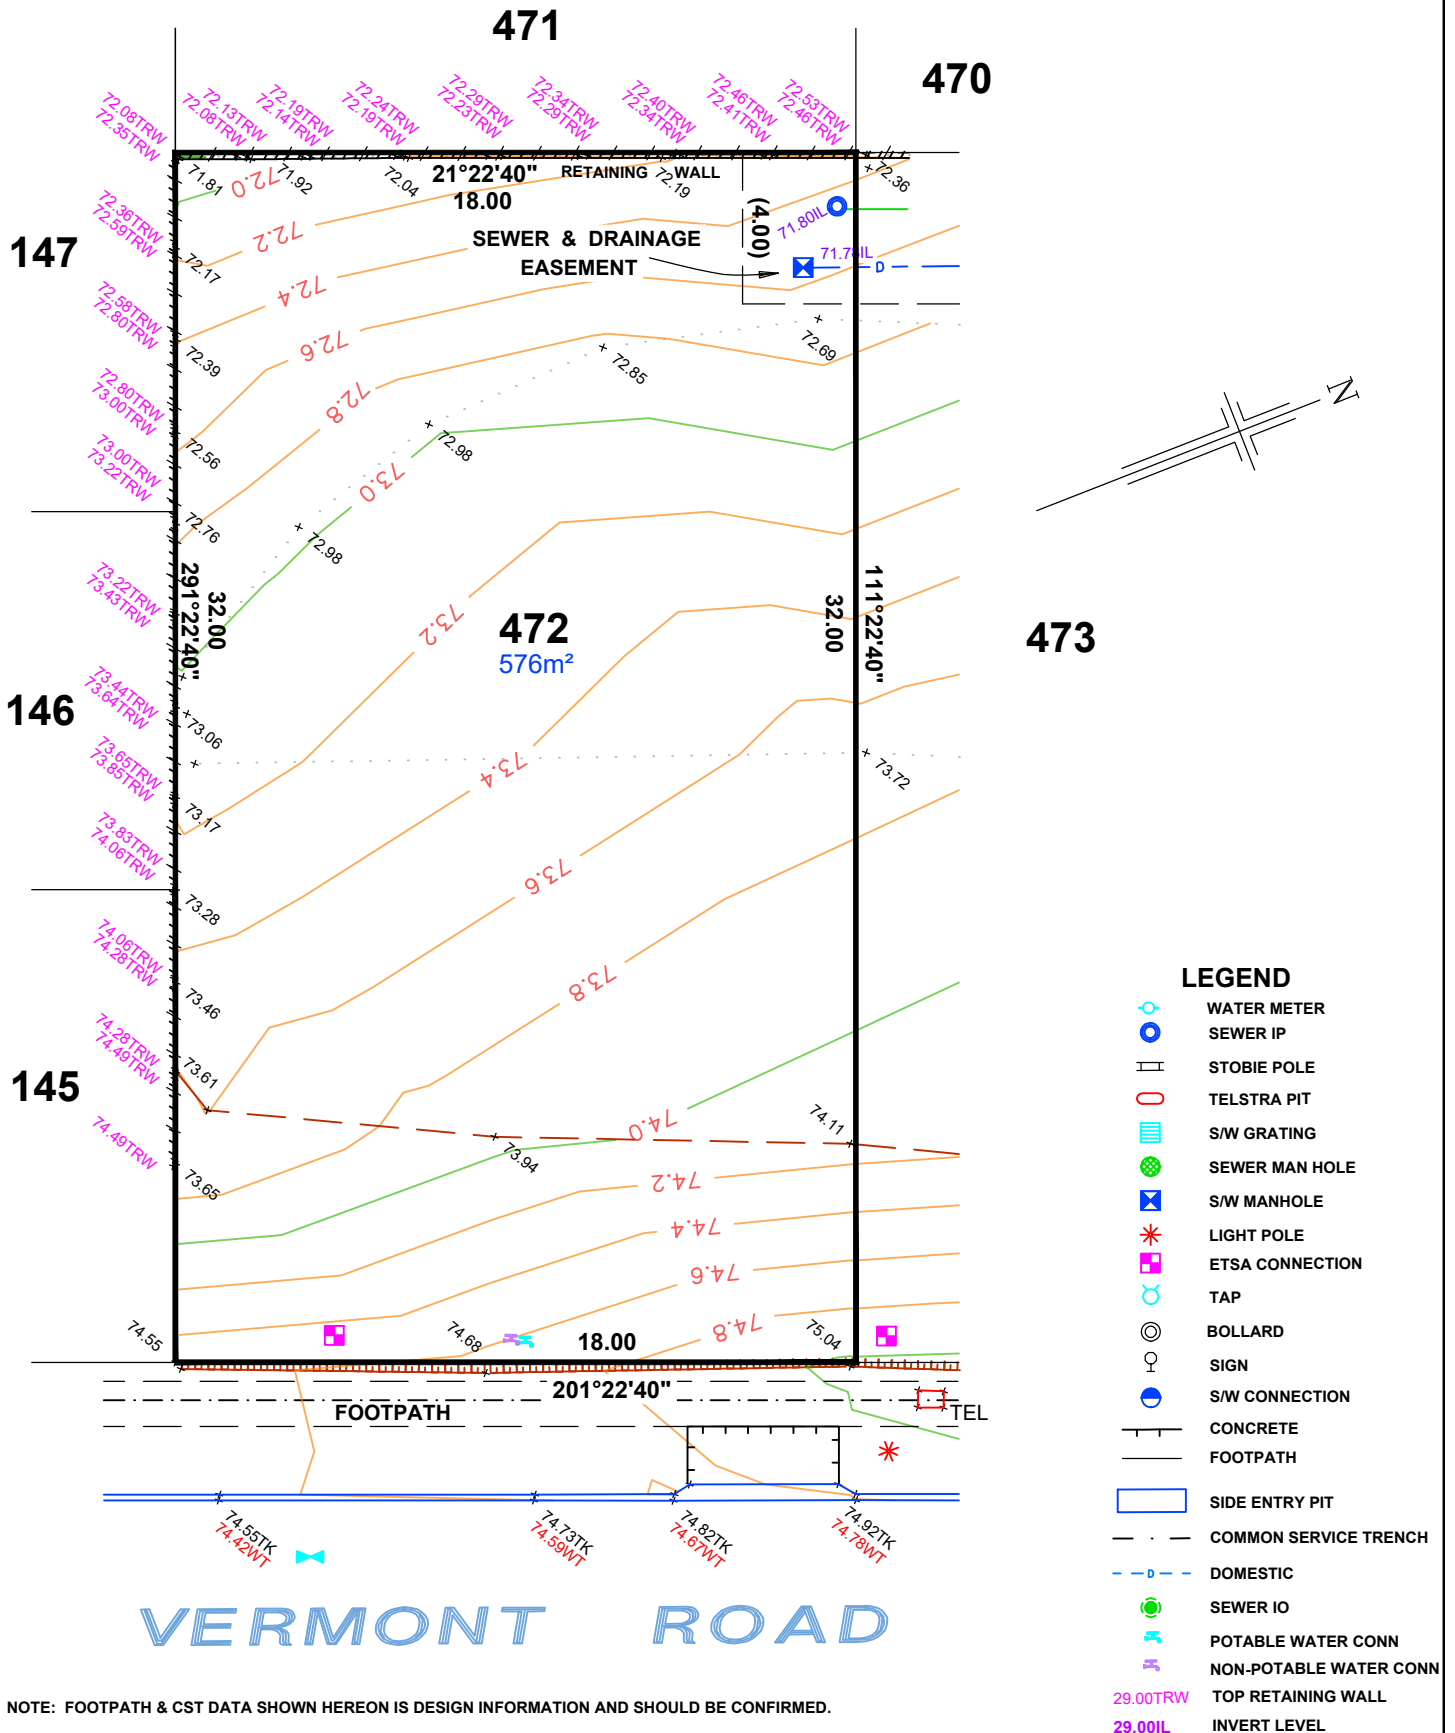

DISCLAIMER:


Please note that this site plan is intended for visual purposes only, additional survey work will be required prior to commencing any design or construction on the site.

ALLOTMENT 473 in DEV. NO. 145/D215/12/007

in the area named
SEAFORD HEIGHTS

CT ---/----

AS CONSTRUCTED

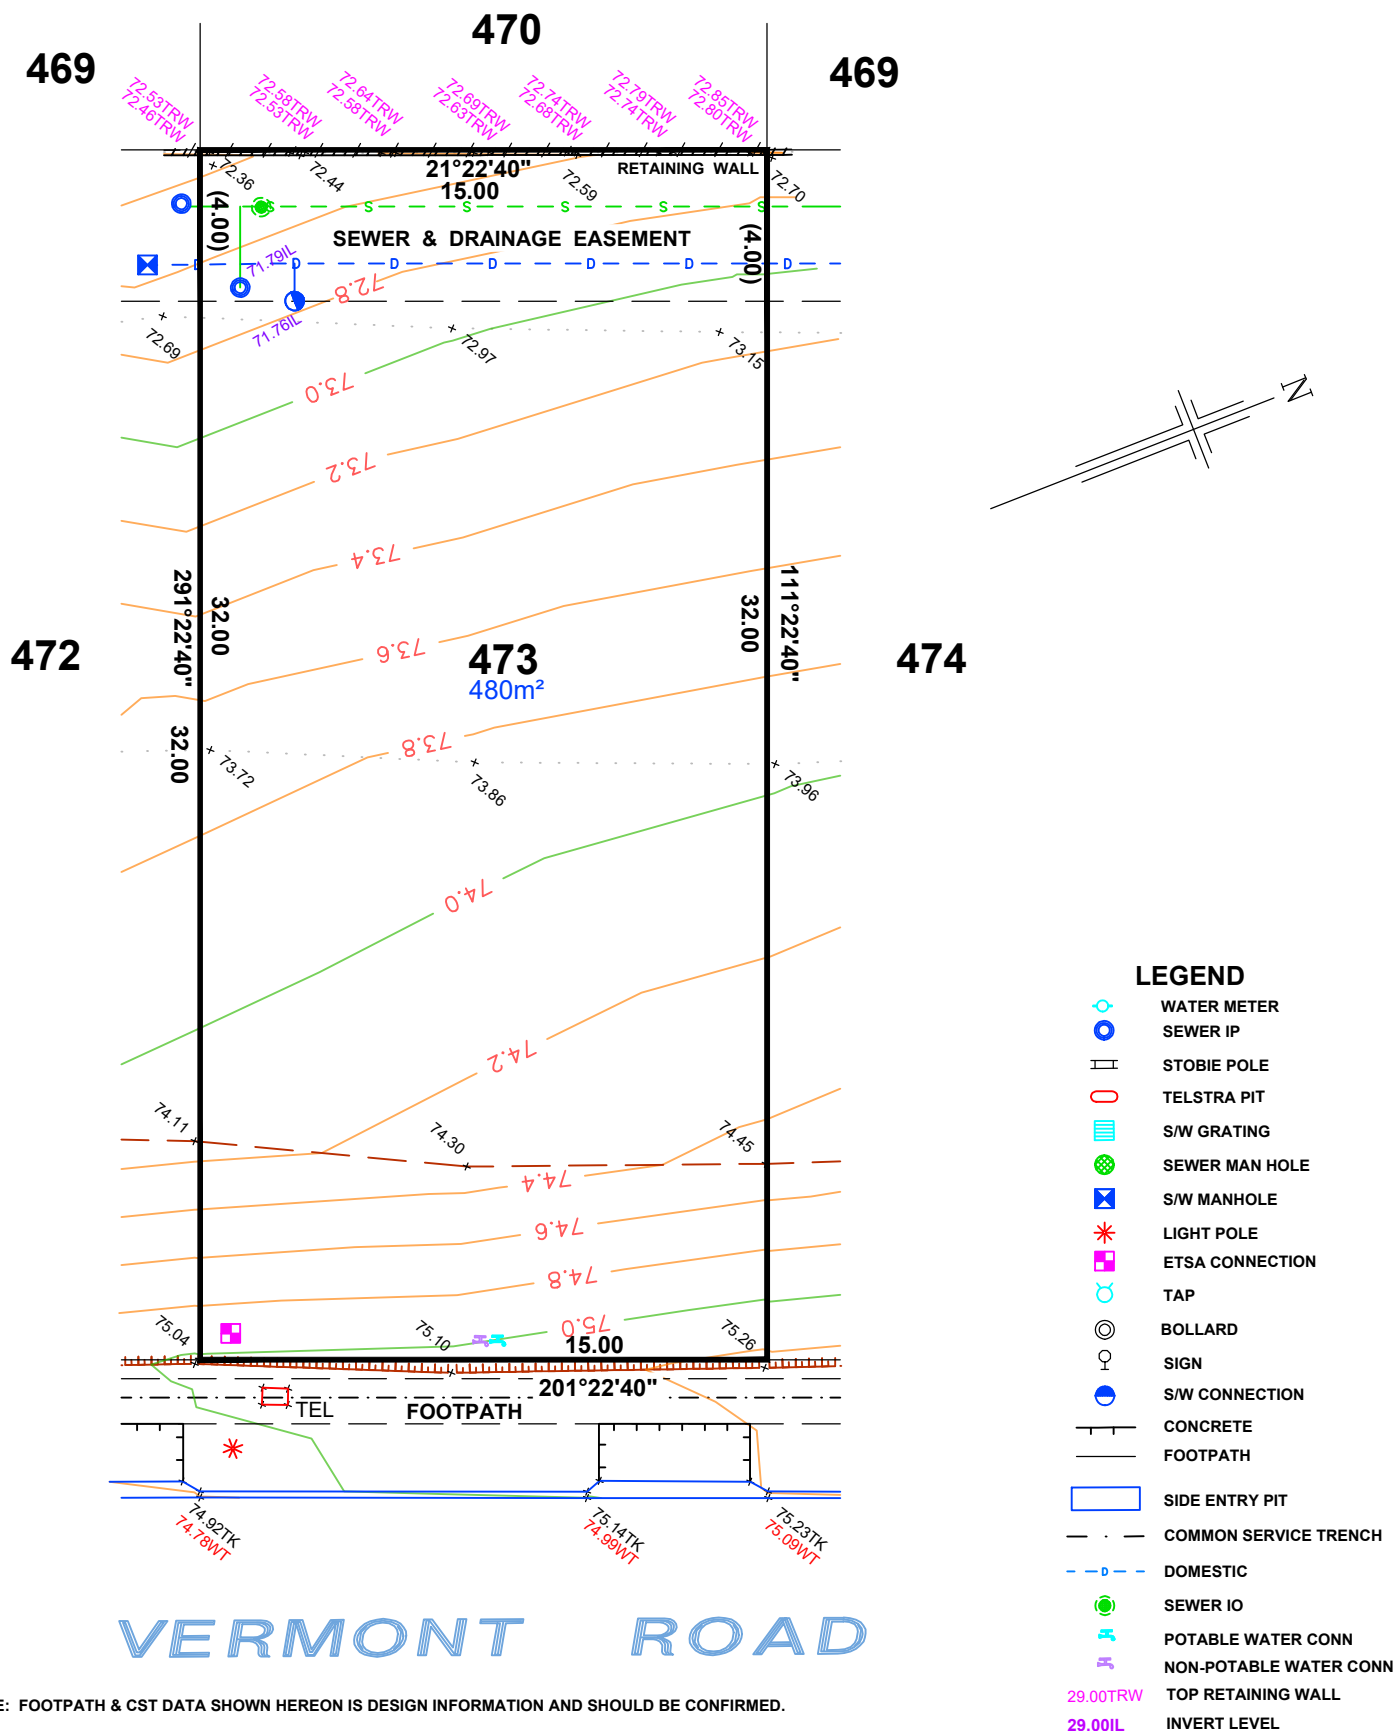

NOTE: FOOTPATH & CST DATA SHOWN HEREON IS DESIGN INFORMATION AND SHOULD BE CONFIRMED.

ALEXANDER SYMONDS
PH 8130 1666

0 2 4 8 12 16 20
1:200
m

ORIGINAL SHEET SIZE A4

DISCLAIMER:


Please note that this site plan is intended for visual purposes only, additional survey work will be required prior to commencing any design or construction on the site.

ALLOTMENT 474 in DEV. NO. 145/D215/12/007

in the area named
SEAFORD HEIGHTS

CT ---/----

AS CONSTRUCTED

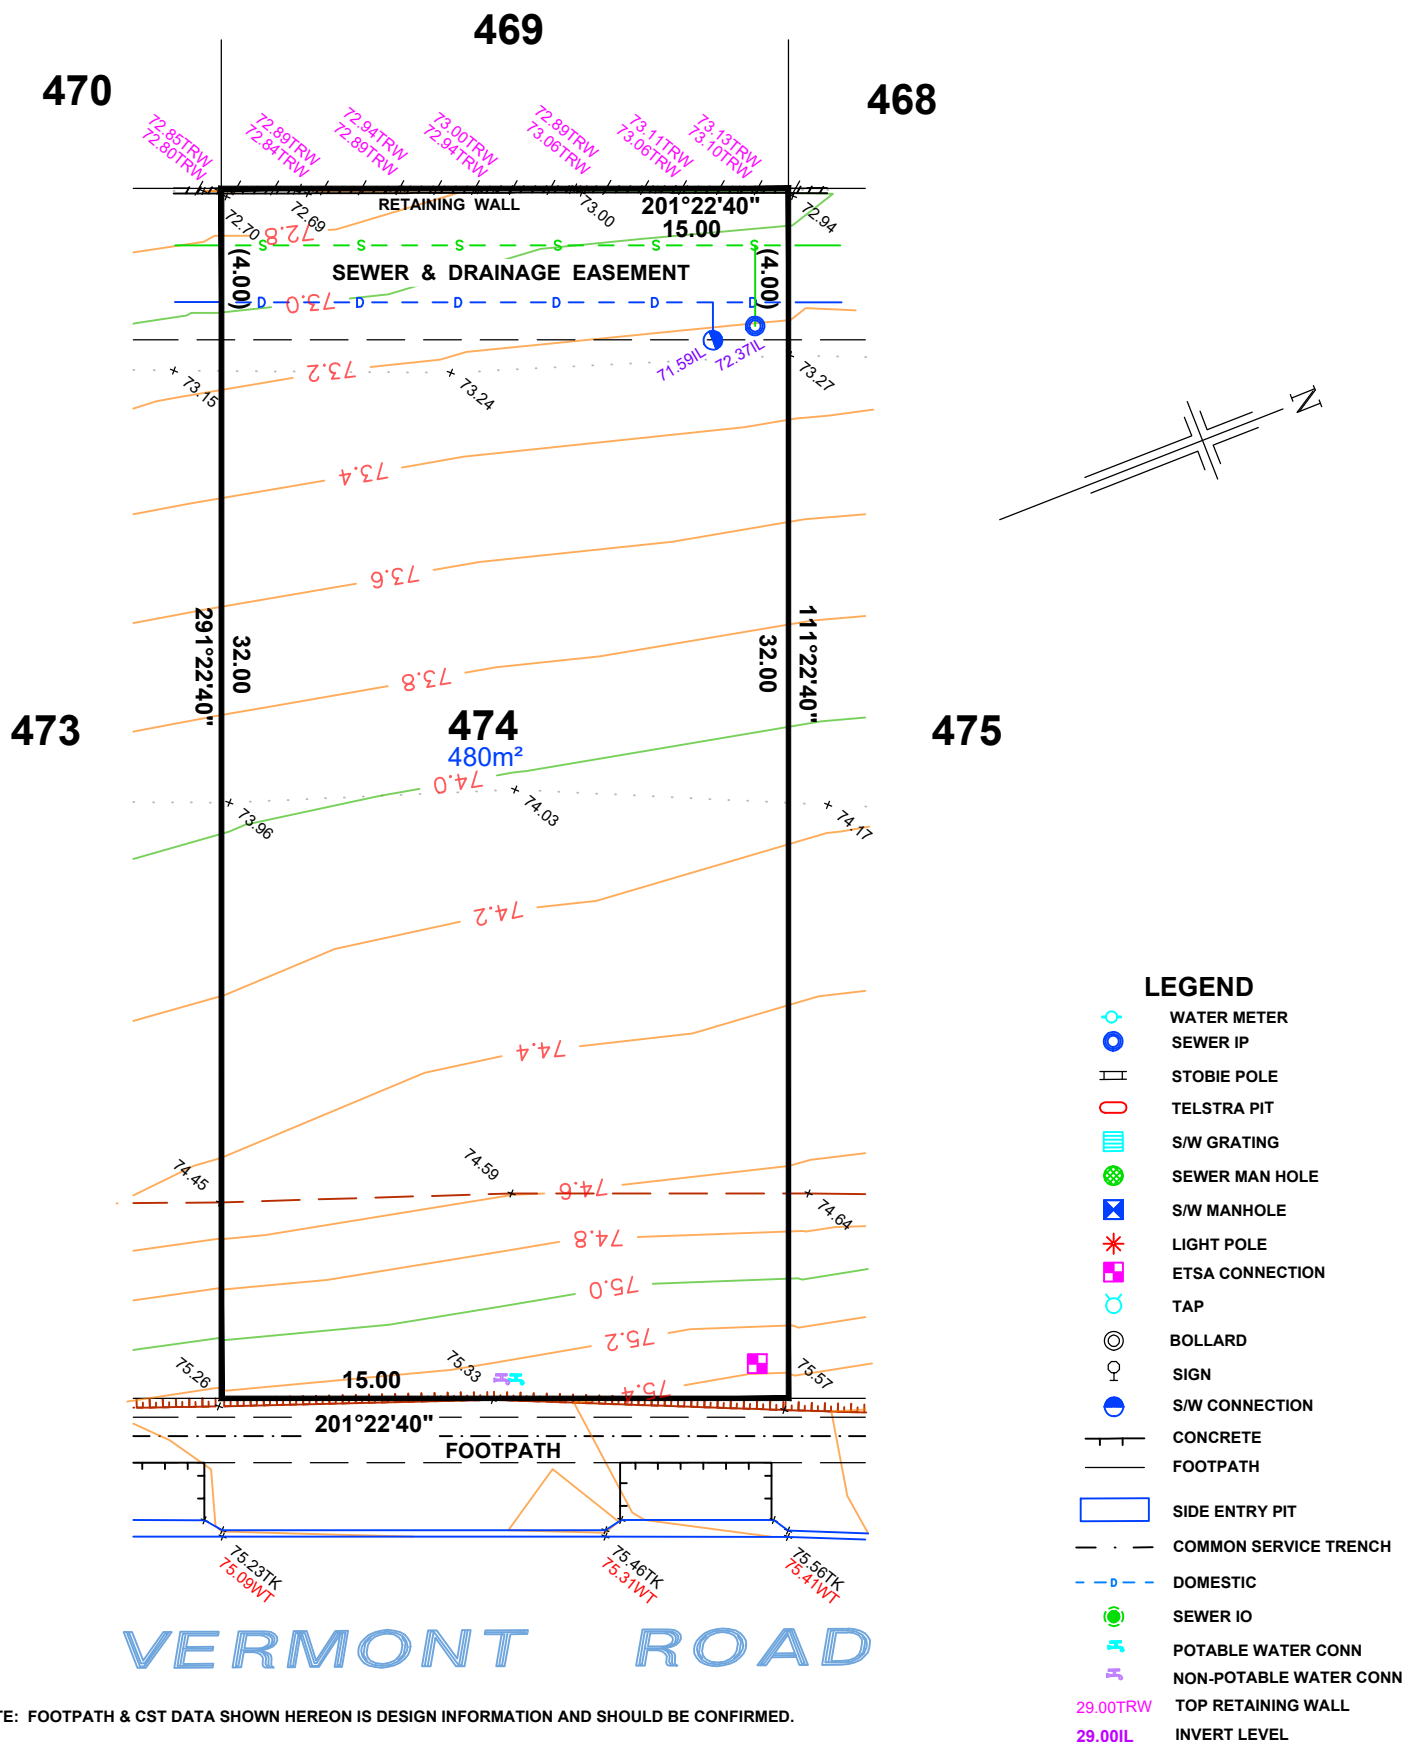

DISCLAIMER:

Please note that this site plan is intended for visual purposes only, additional survey work will be required prior to commencing any design or construction on the site.

ALLOTMENT 475 in DEV. NO. 145/D215/12/007

in the area named
SEAFORD HEIGHTS

CT ---/----

AS CONSTRUCTED

469

468

467

474

475

566m²

476

VERMONT ROAD

NOTE: FOOTPATH & CST DATA SHOWN HEREON IS DESIGN INFORMATION AND SHOULD BE CONFIRMED.

ALEXANDER SYMONDS
PH 8130 1666



1:200

ORIGINAL SHEET SIZE A4


LEGEND

- WATER METER
- SEWER IP
- STOBIE POLE
- TELSTRA PIT
- S/W GRATING
- SEWER MAN HOLE
- S/W MANHOLE
- LIGHT POLE
- ETSA CONNECTION
- TAP
- BOLLARD
- SIGN
- S/W CONNECTION
- CONCRETE
- FOOTPATH
- SIDE ENTRY PIT
- COMMON SERVICE TRENCH
- DOMESTIC
- SEWER IO
- POTABLE WATER CONN
- NON-POTABLE WATER CONN
- 29.00TRW TOP RETAINING WALL
- 29.00IL INVERT LEVEL

DISCLAIMER:
Please note that this site plan is intended for visual purposes only, additional survey work will be required prior to commencing any design or construction on the site.

ALLOTMENT 476 in DEV. NO. 145/D215/12/007
in the area named
SEAFORD HEIGHTS
CT ---/----


AS CONSTRUCTED

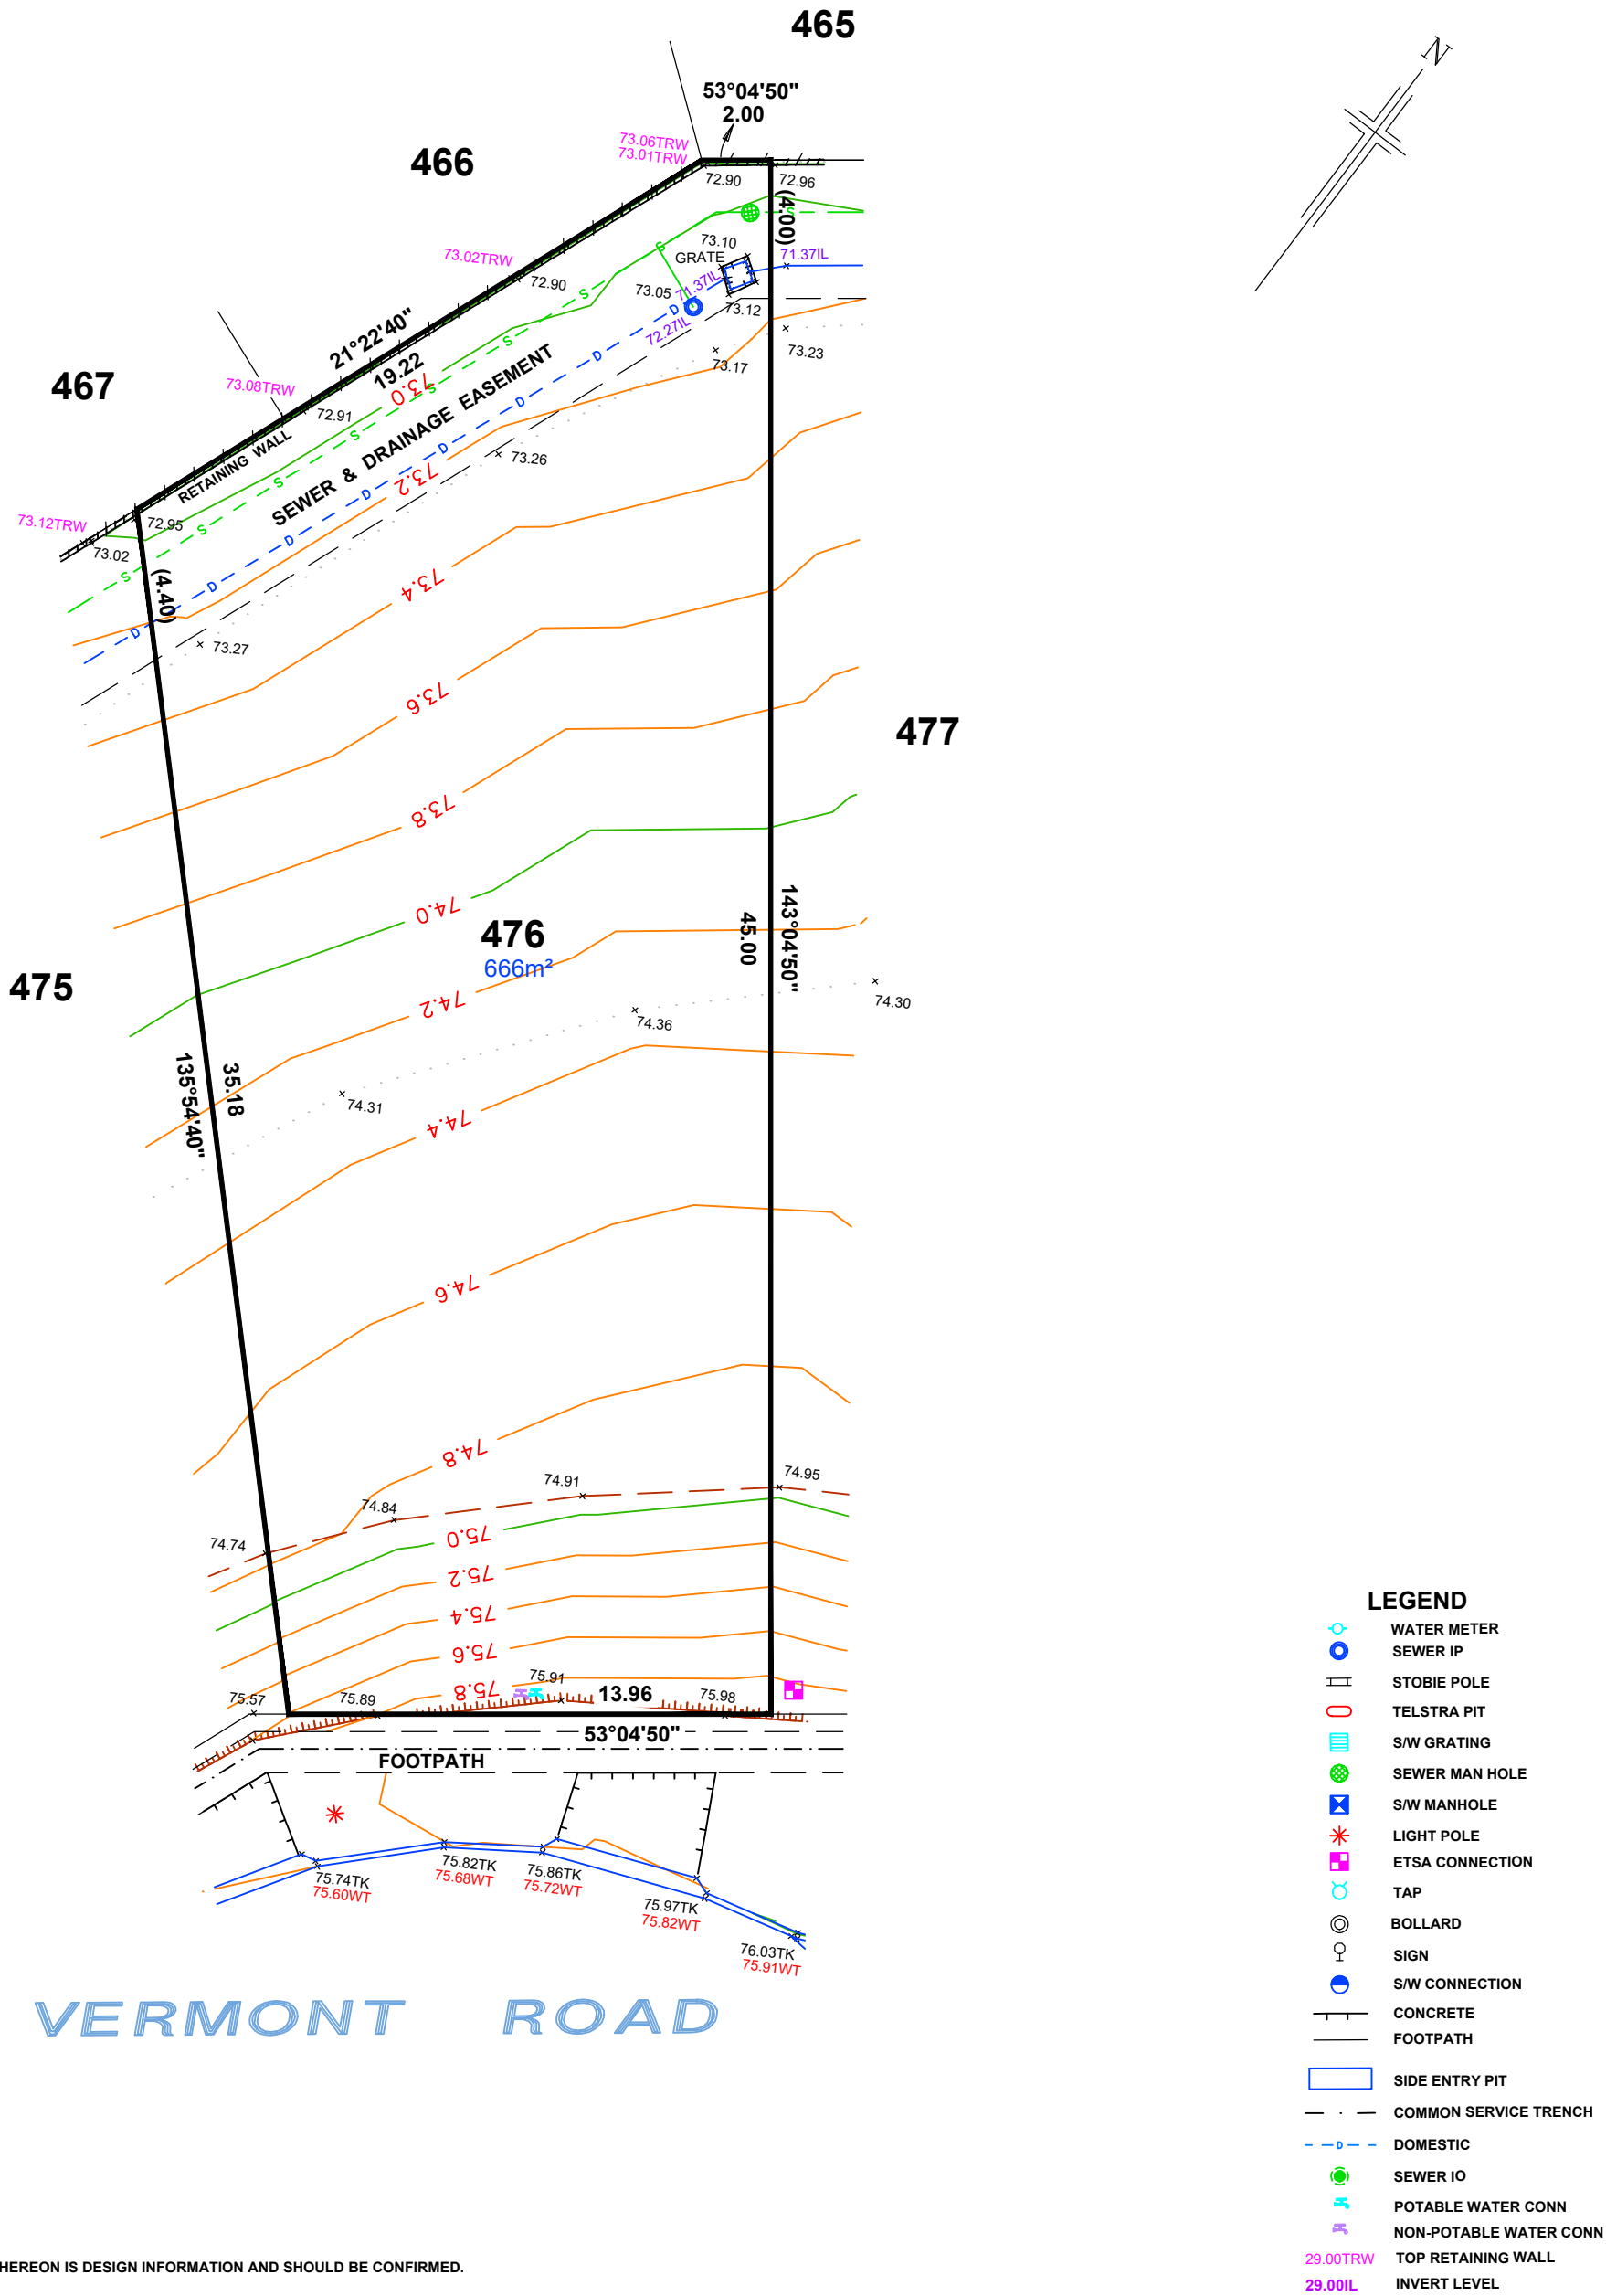

DISCLAIMER:
Please note that this site plan is intended for visual purposes only, additional survey work will be required prior to commencing any design or construction on the site.

ALLOTMENT 477 in DEV. NO. 145/D215/12/007
in the area named
SEAFORD HEIGHTS
CT ---/----




AS CONSTRUCTED

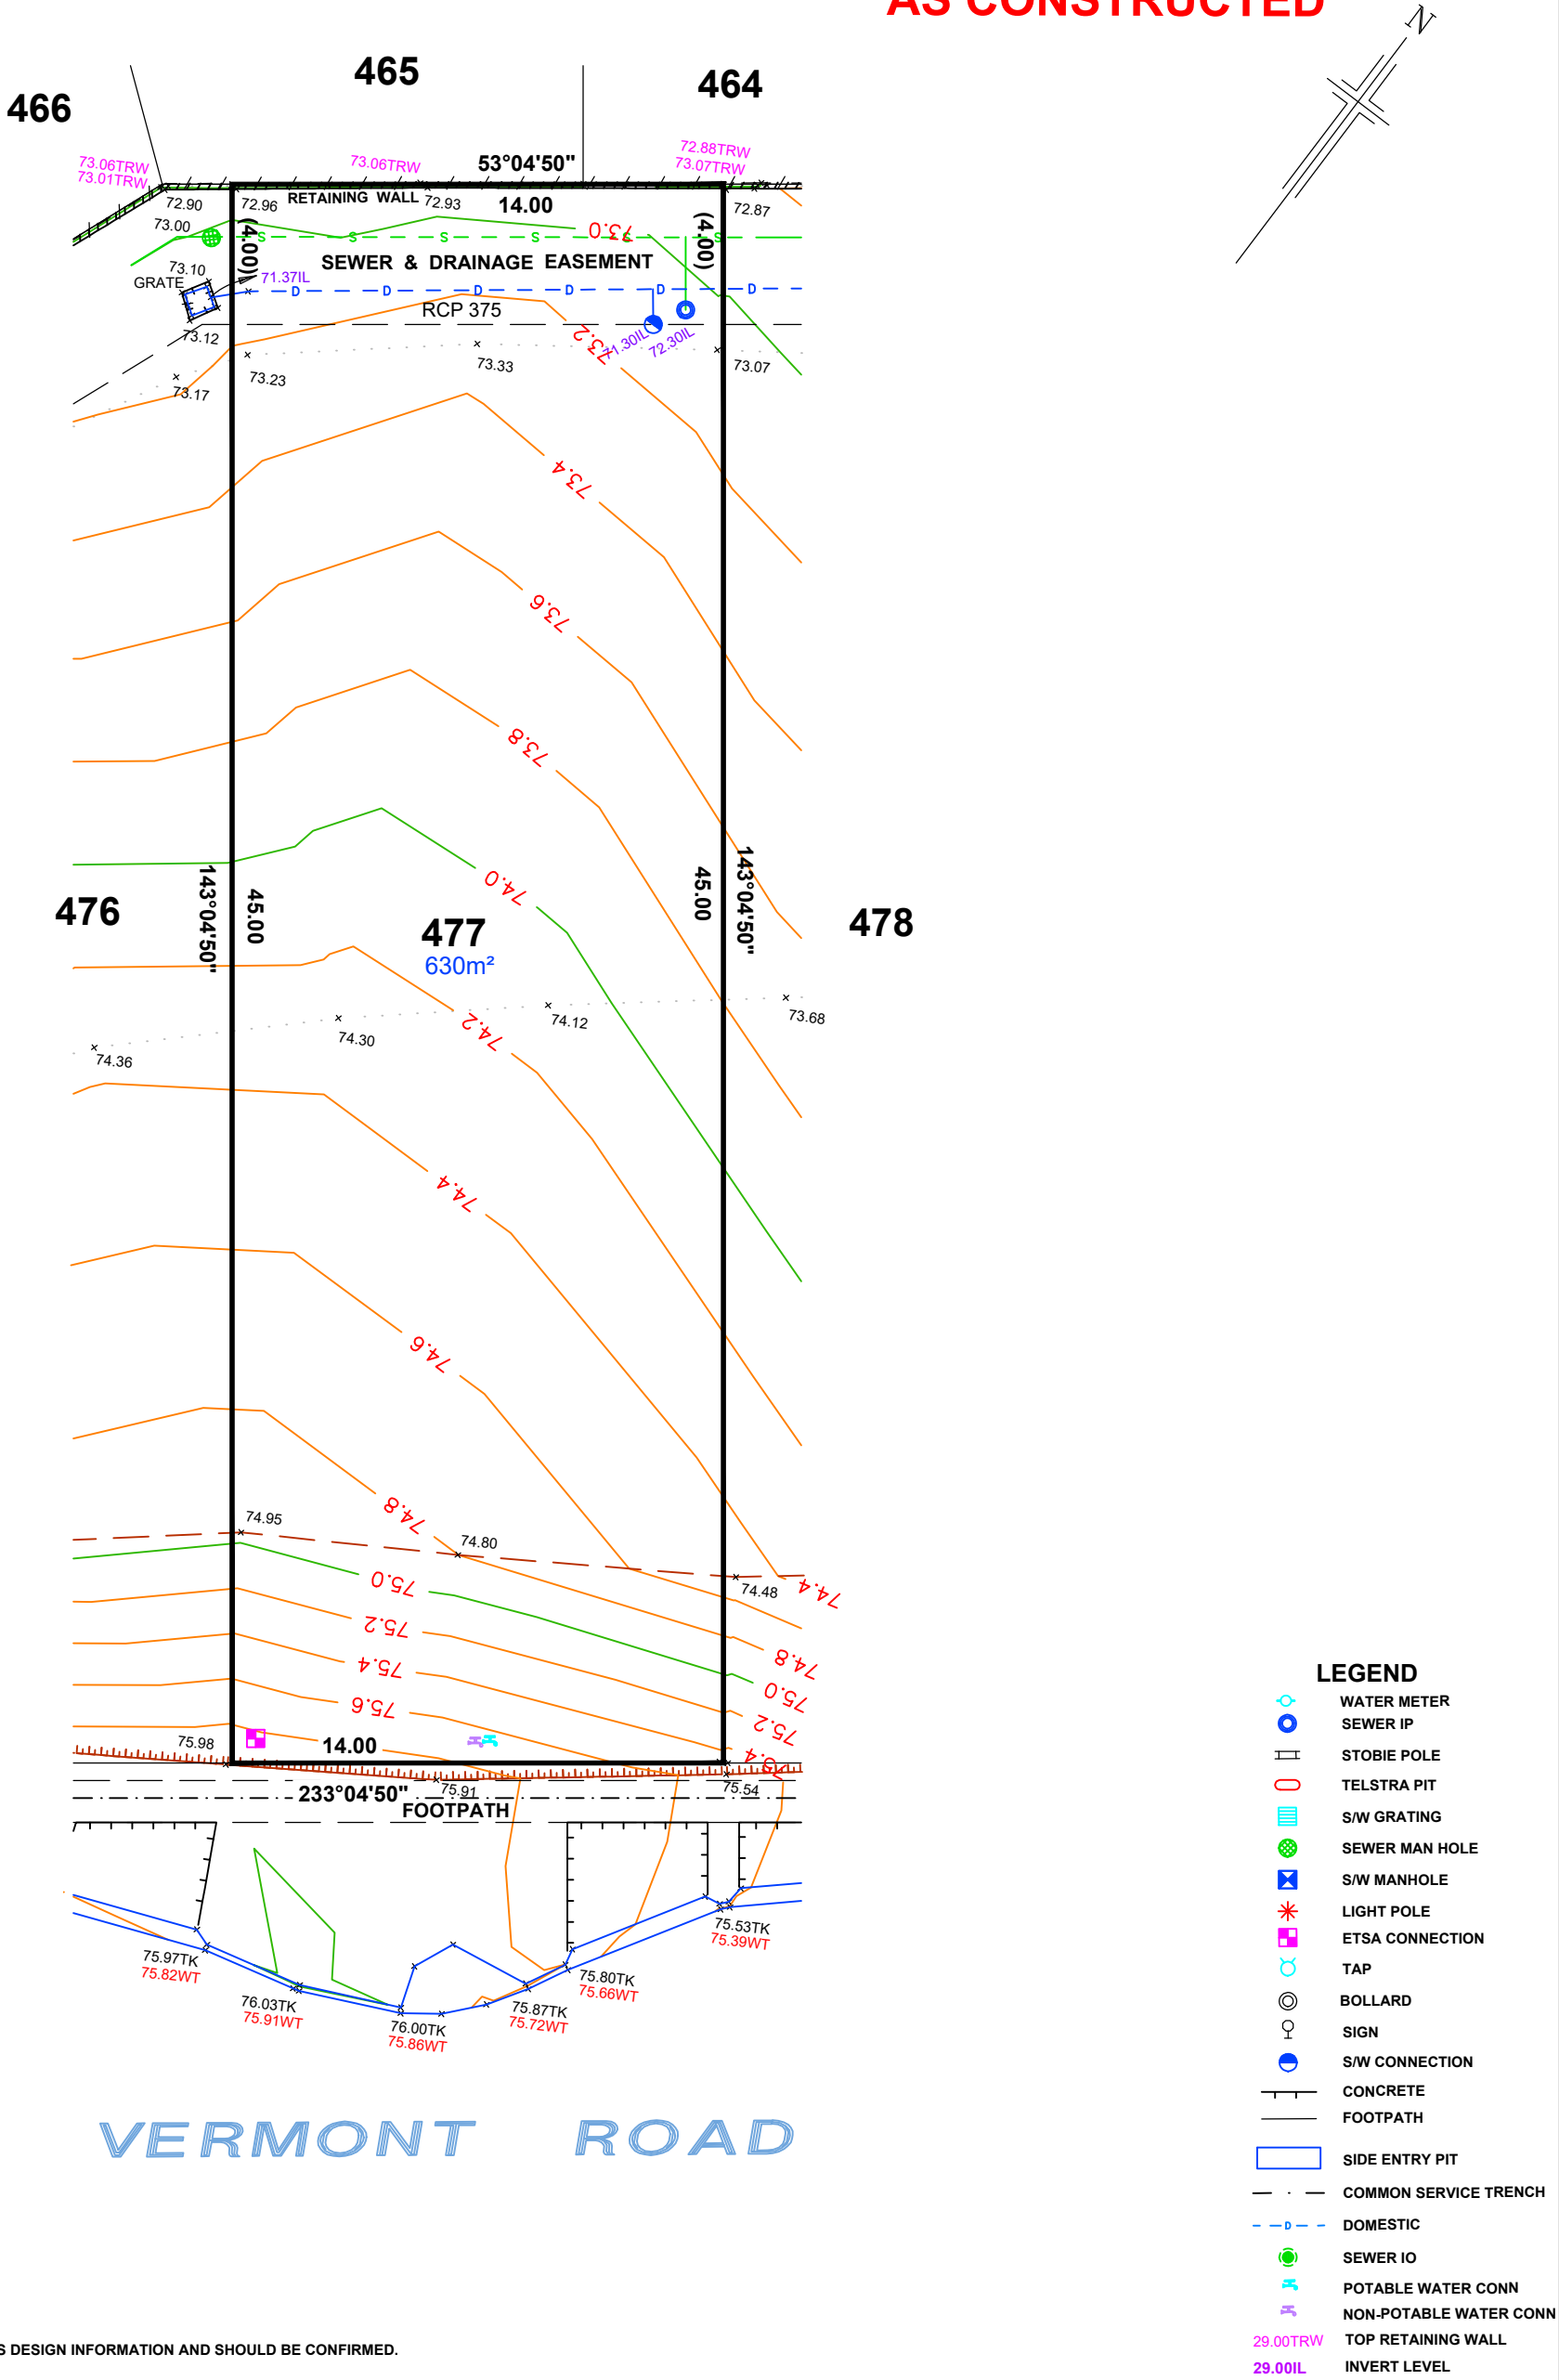

DISCLAIMER:
Please note that this site plan is intended for visual purposes only, additional survey work will be required prior to commencing any design or construction on the site.


ALLOTMENT 478 in DEV. NO. 145/D215/12/007
in the area named
SEAFORD HEIGHTS
CT ---/----

AS CONSTRUCTED

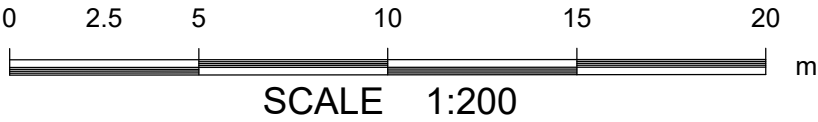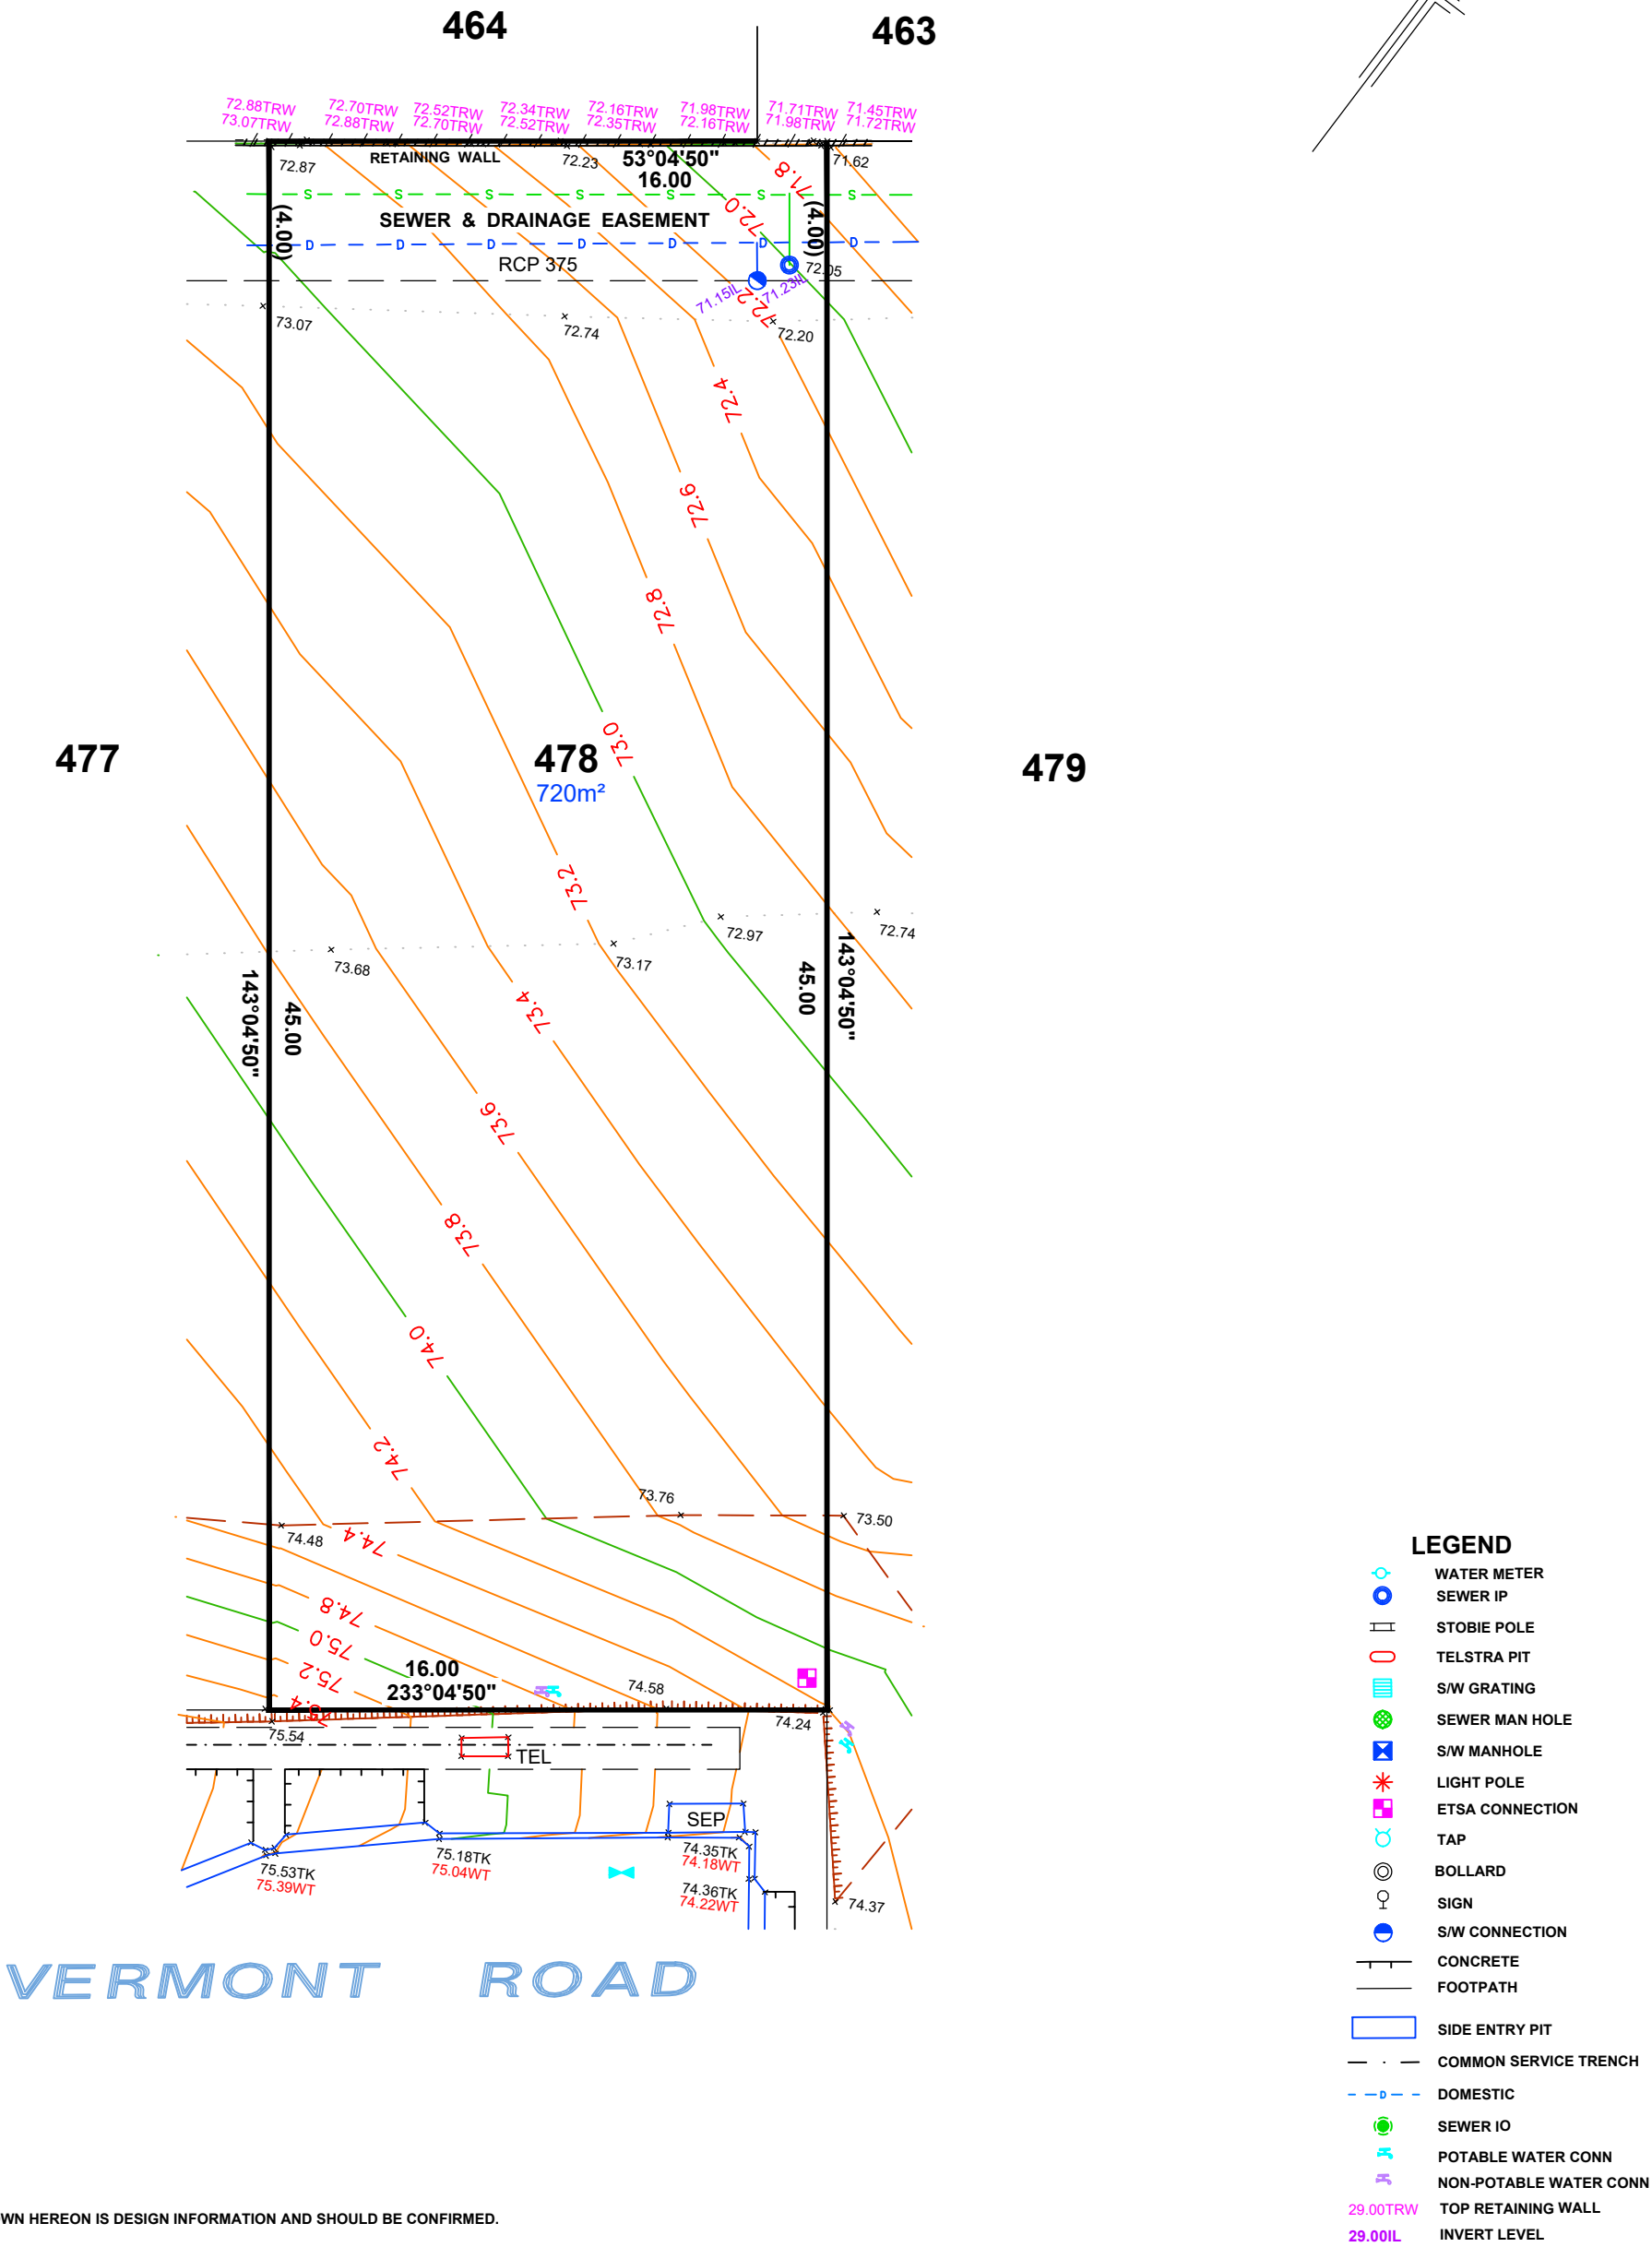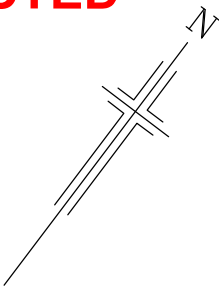

DISCLAIMER:
Please note that this site plan is intended for visual purposes only, additional survey work will be required prior to commencing any design or construction on the site.

ALLOTMENT 479 in DEV. NO. 145/D215/12/007
in the area named
SEAFORD HEIGHTS
AS CONSTRUCTED

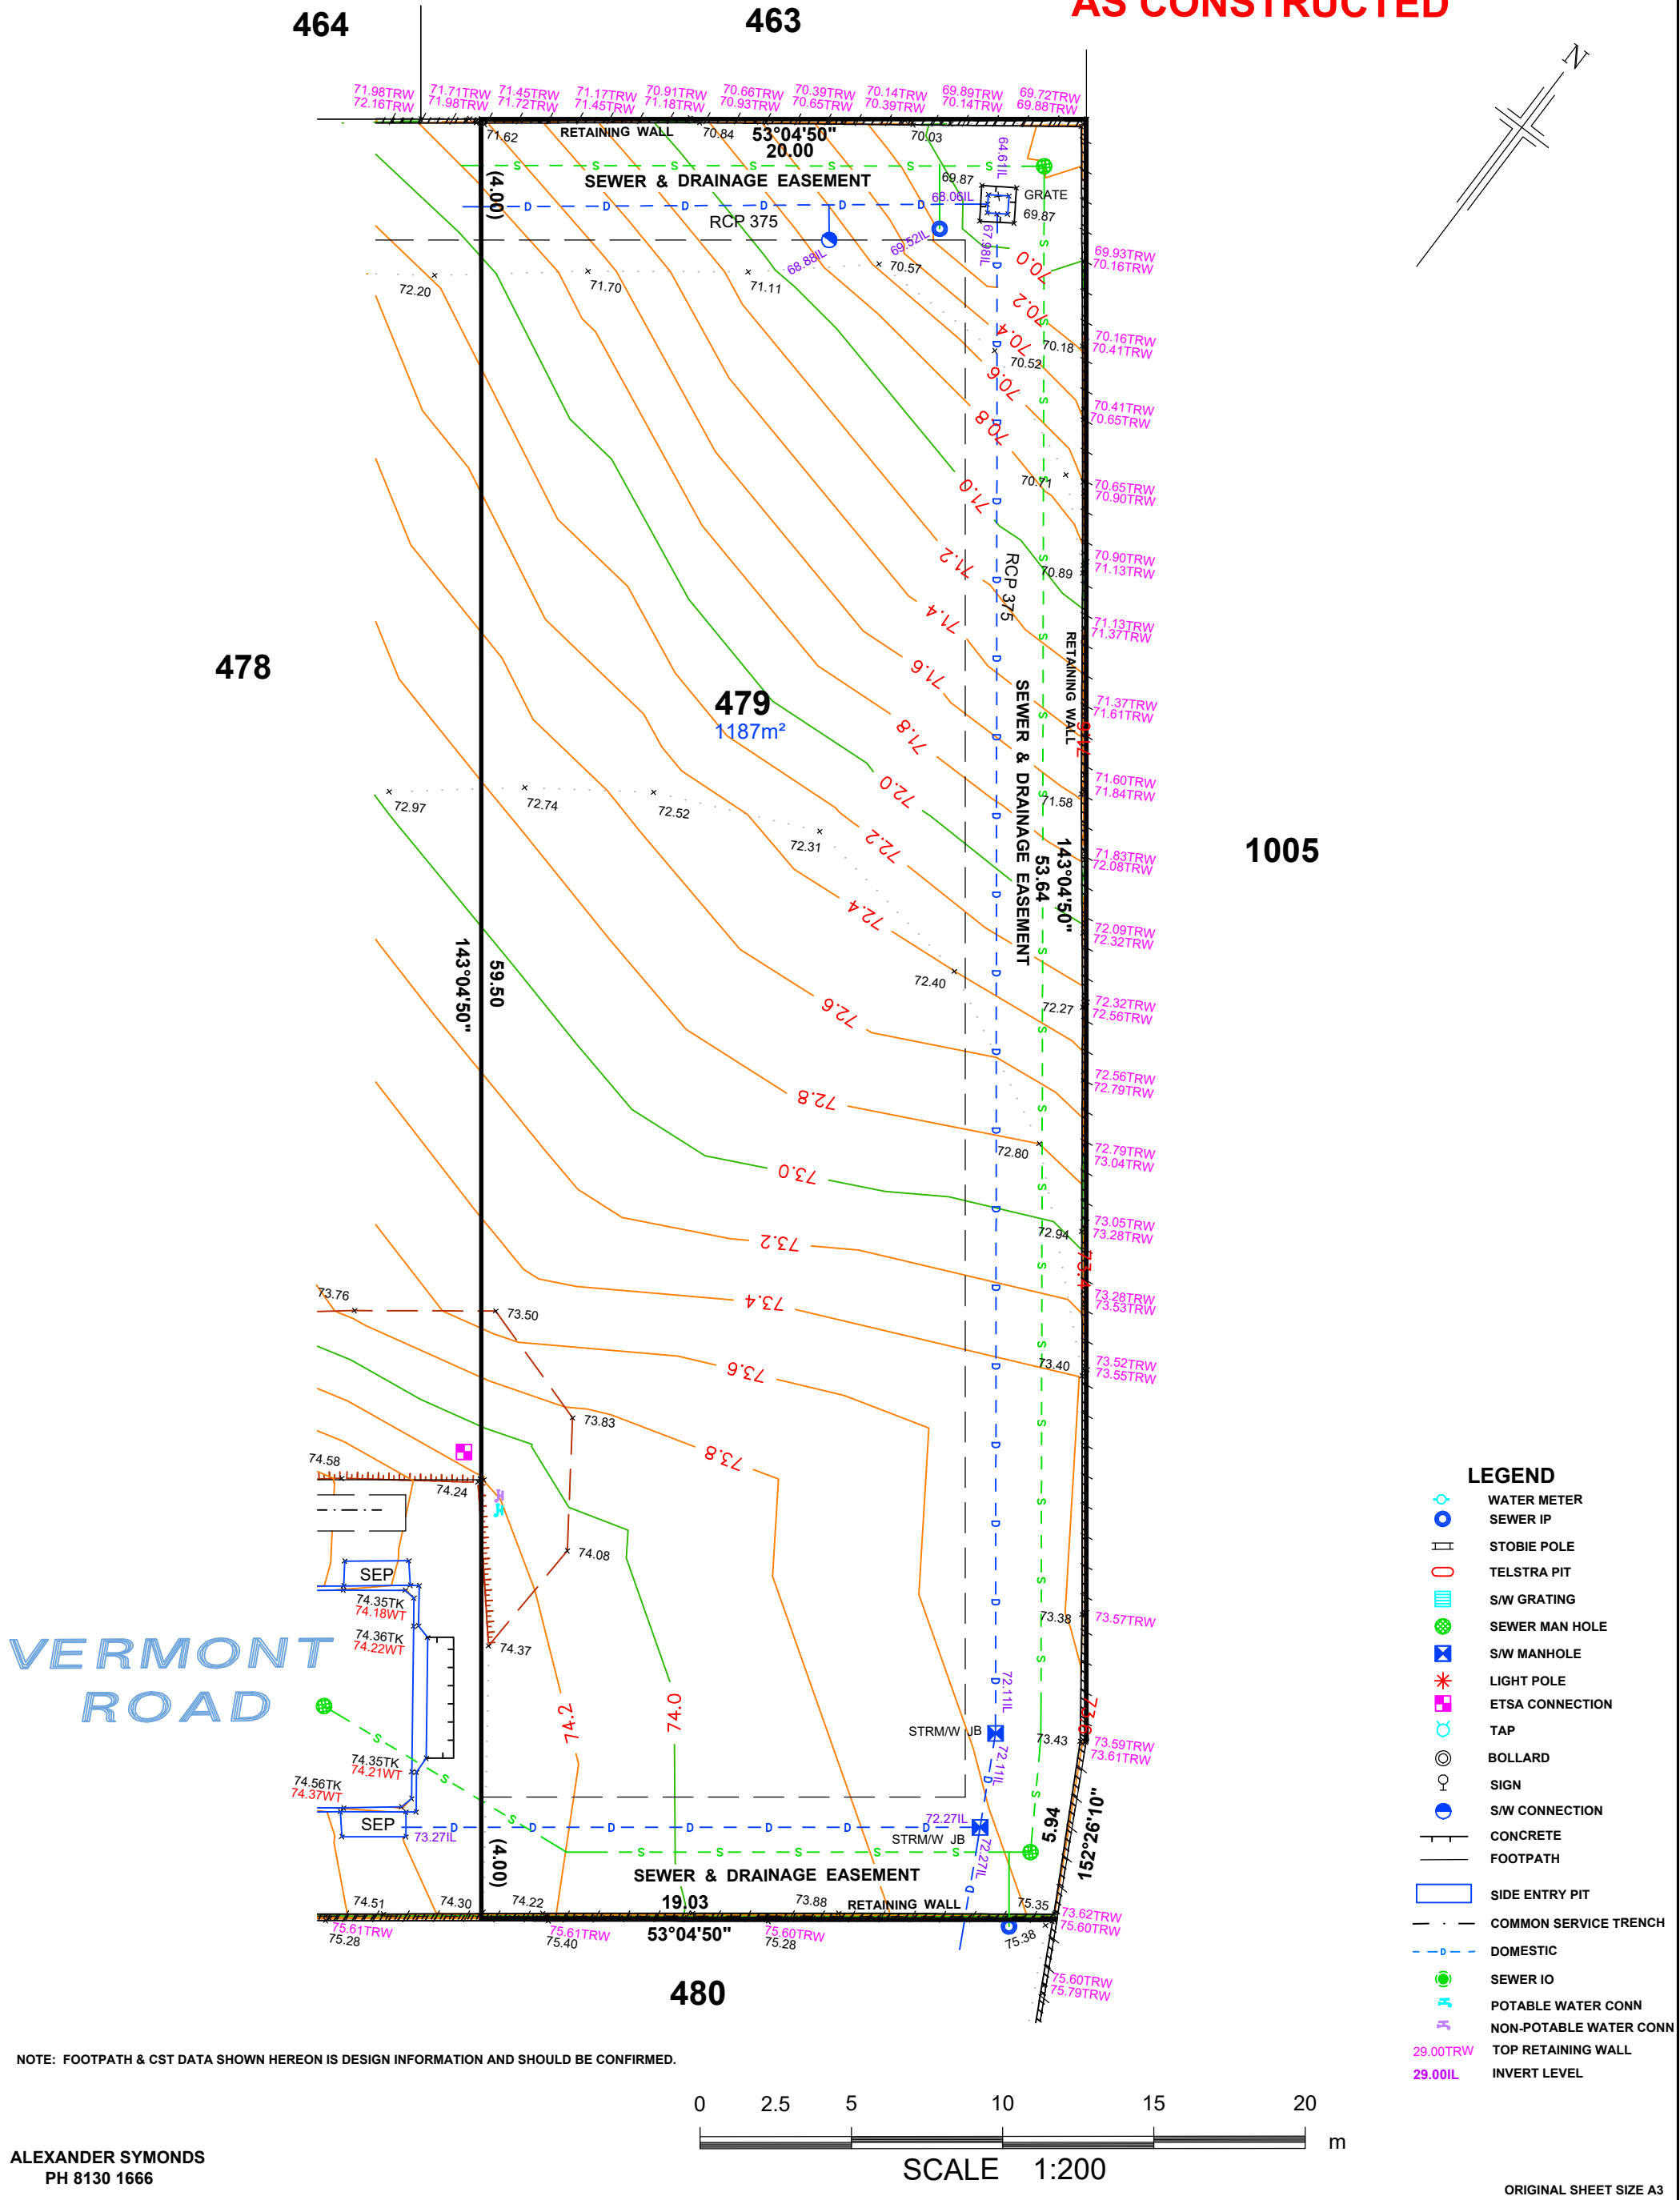

Please note that this site plan is intended for visual purposes only, additional survey work will be required prior to commencing any design or construction on the site.

CT ---/----

A diagram showing a line with a crossbar and a label 'M' at the top right.



1:200

ORIGINAL SHEET SIZE A4

DISCLAIMER:


Please note that this site plan is intended for visual purposes only, additional survey work will be required prior to commencing any design or construction on the site.

ALLOTMENT 481 in DEV. NO. 145/D215/12/007

in the area named
SEAFORD HEIGHTS

CT ---/----

AS CONSTRUCTED

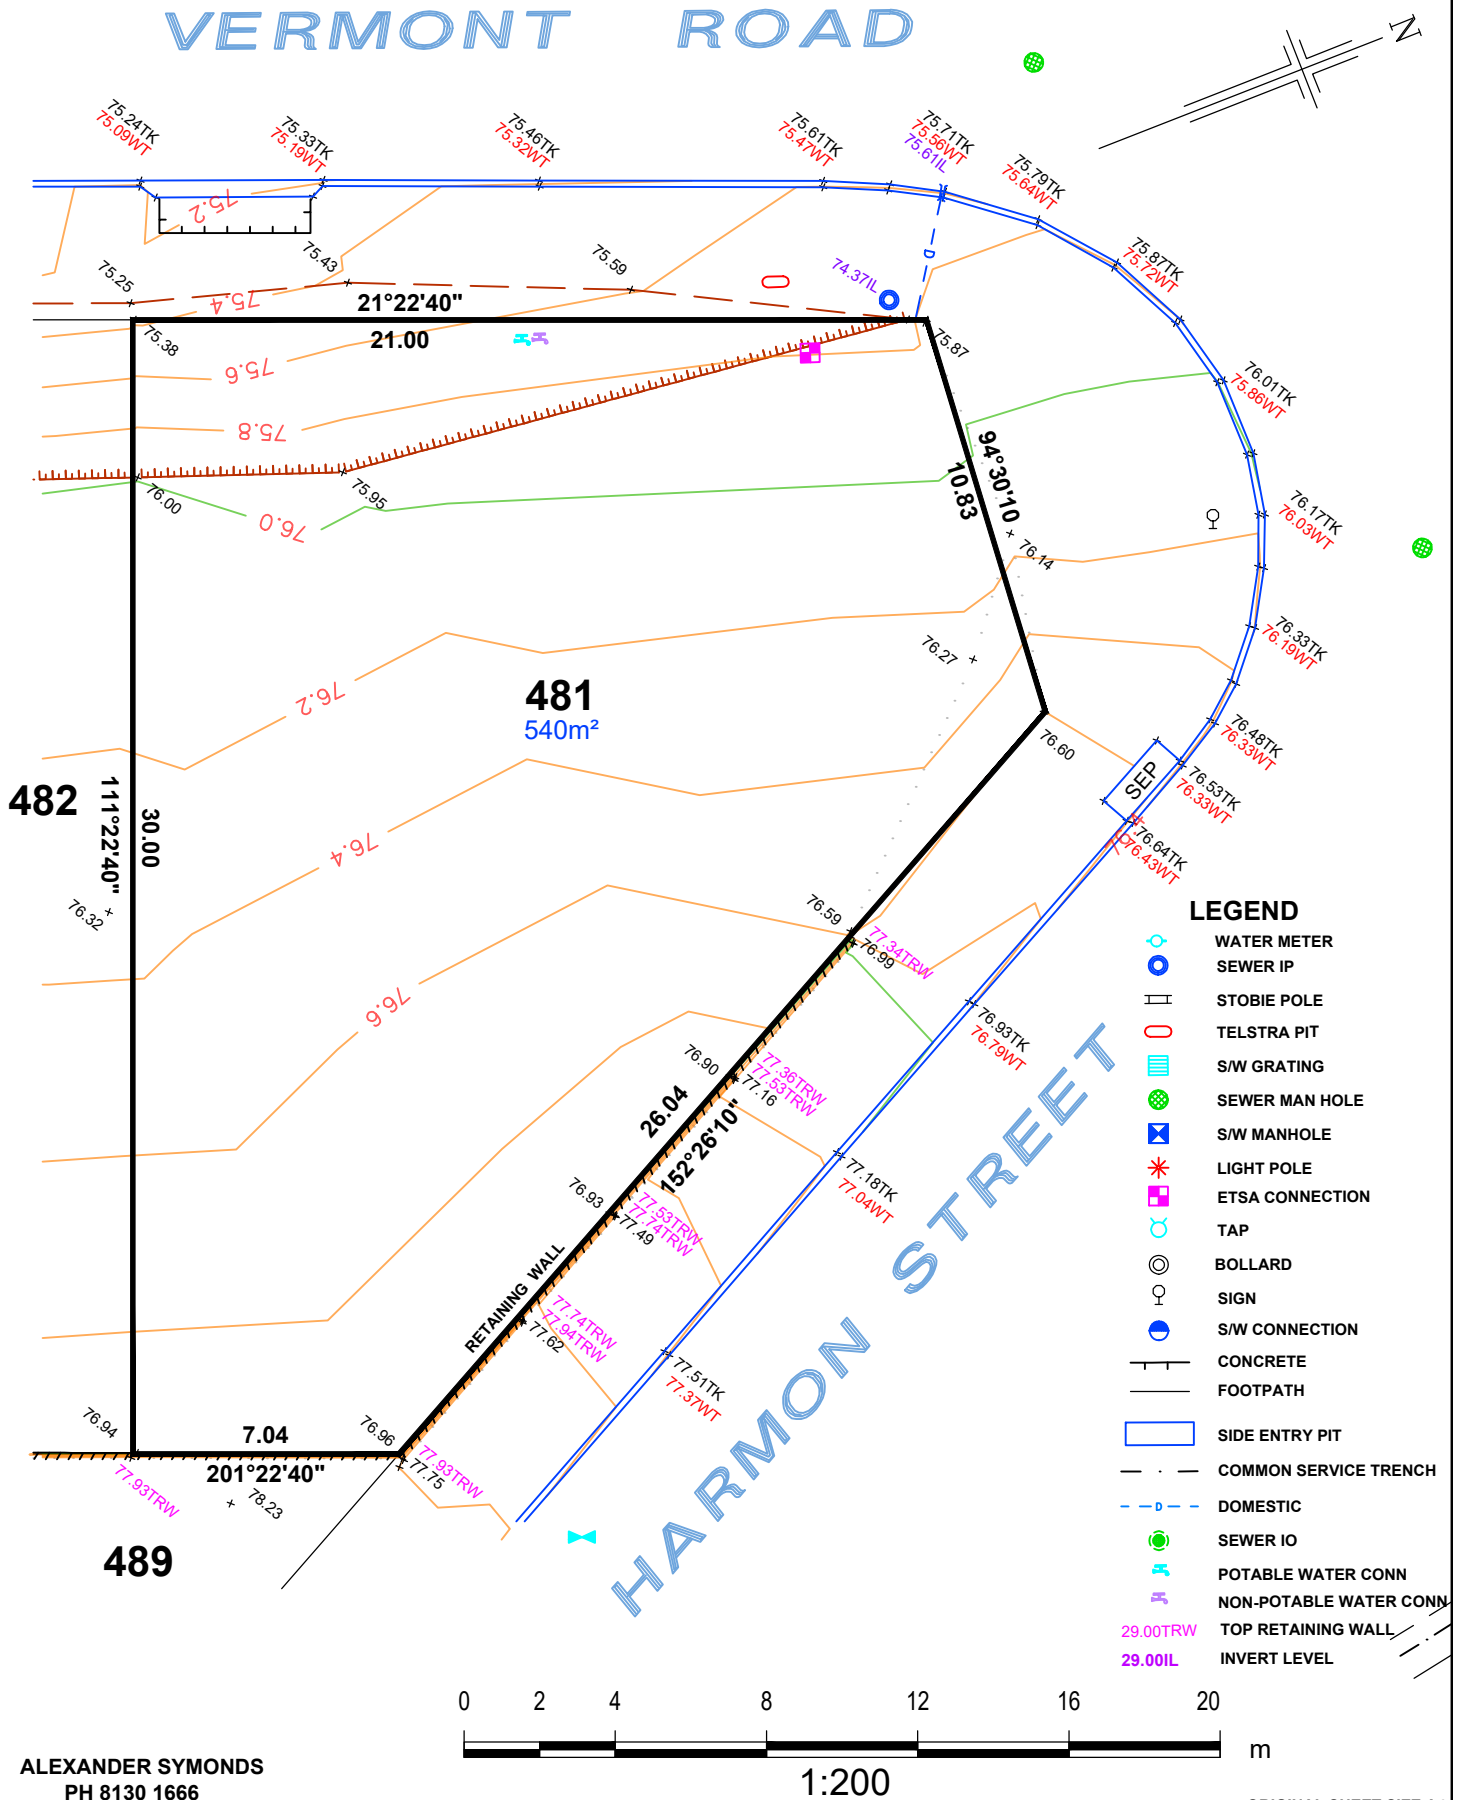

DISCLAIMER:

Please note that this site plan is intended for visual purposes only, additional survey work will be required prior to commencing any design or construction on the site.

ALLOTMENT 482 in DEV. NO. 145/D215/12/007


in the area named

SEAFORD HEIGHTS

CT ---/----

AS CONSTRUCTED

VERMONT ROAD

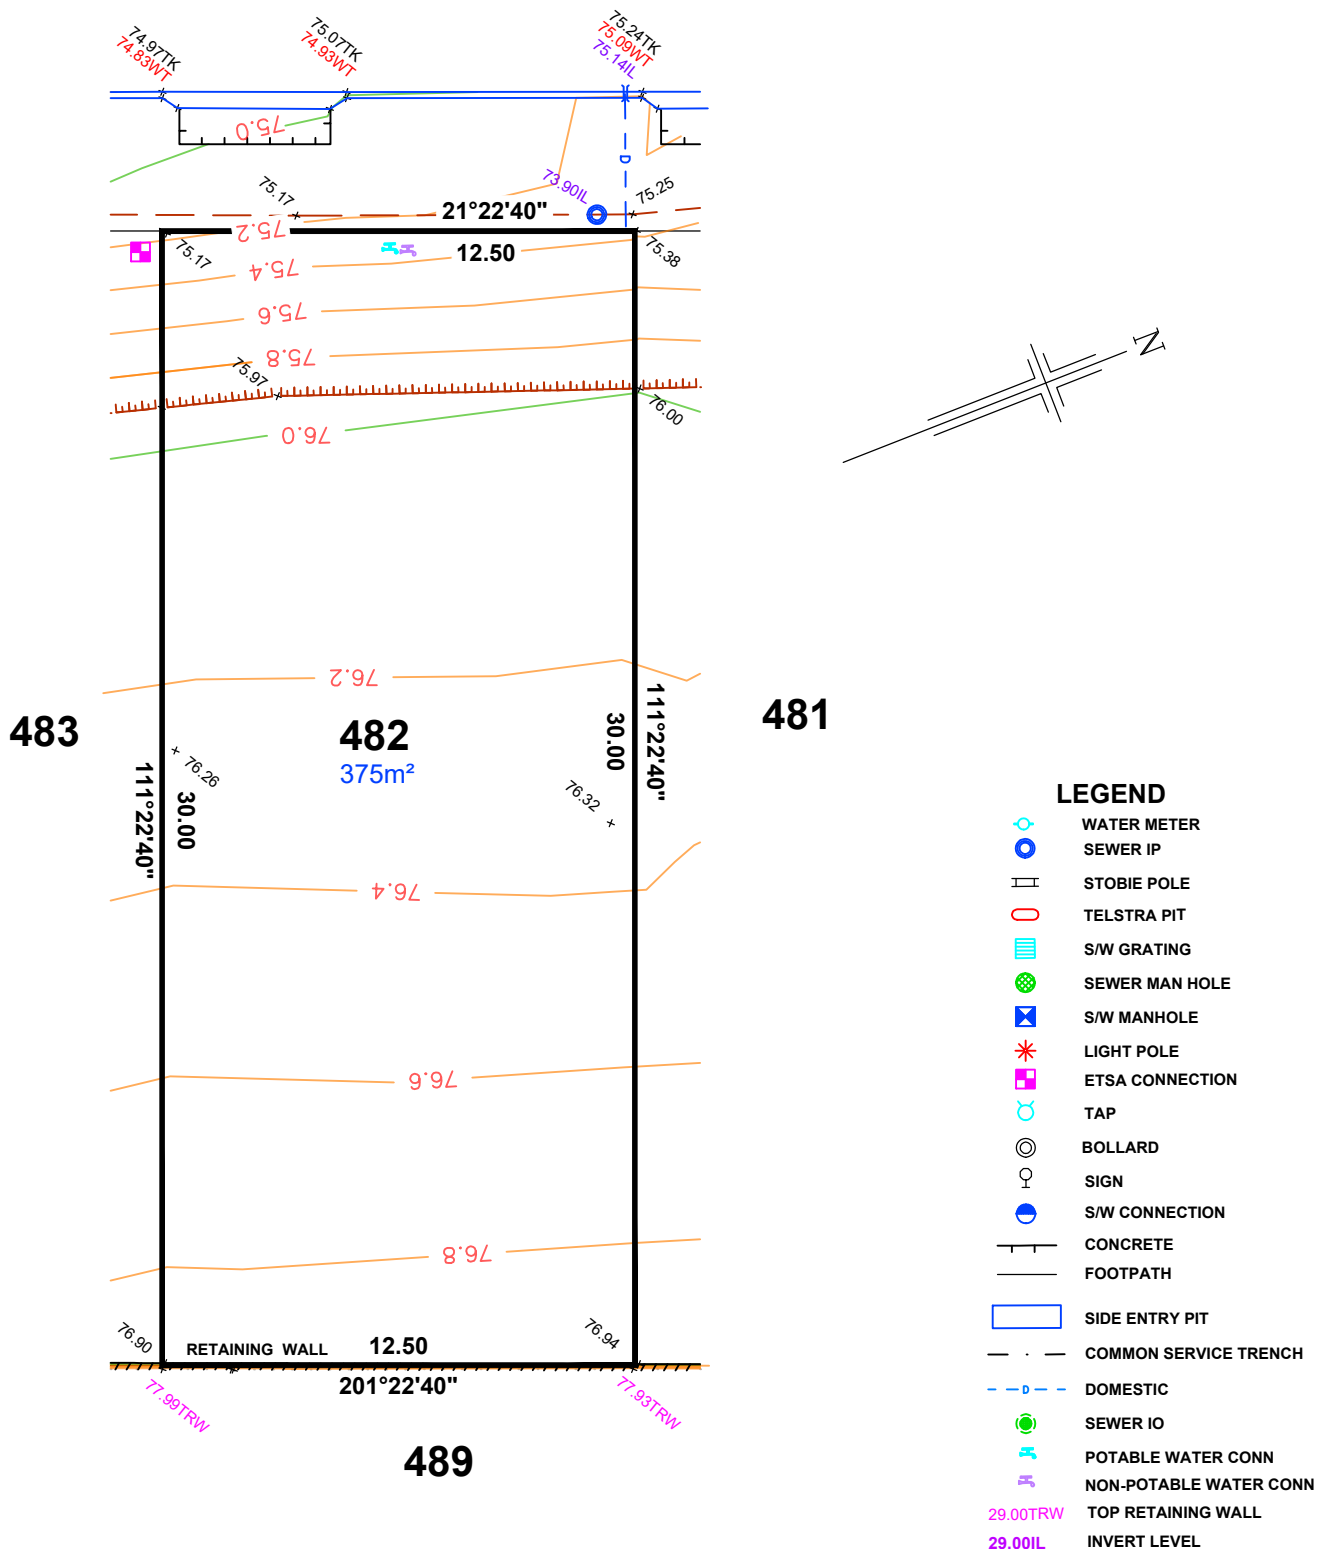

DISCLAIMER:


Please note that this site plan is intended for visual purposes only, additional survey work will be required prior to commencing any design or construction on the site.

ALLOTMENT 483 in DEV. NO. 145/D215/12/007

**in the area named
SEAFORD HEIGHTS**

CT ---/----

AS CONSTRUCTED

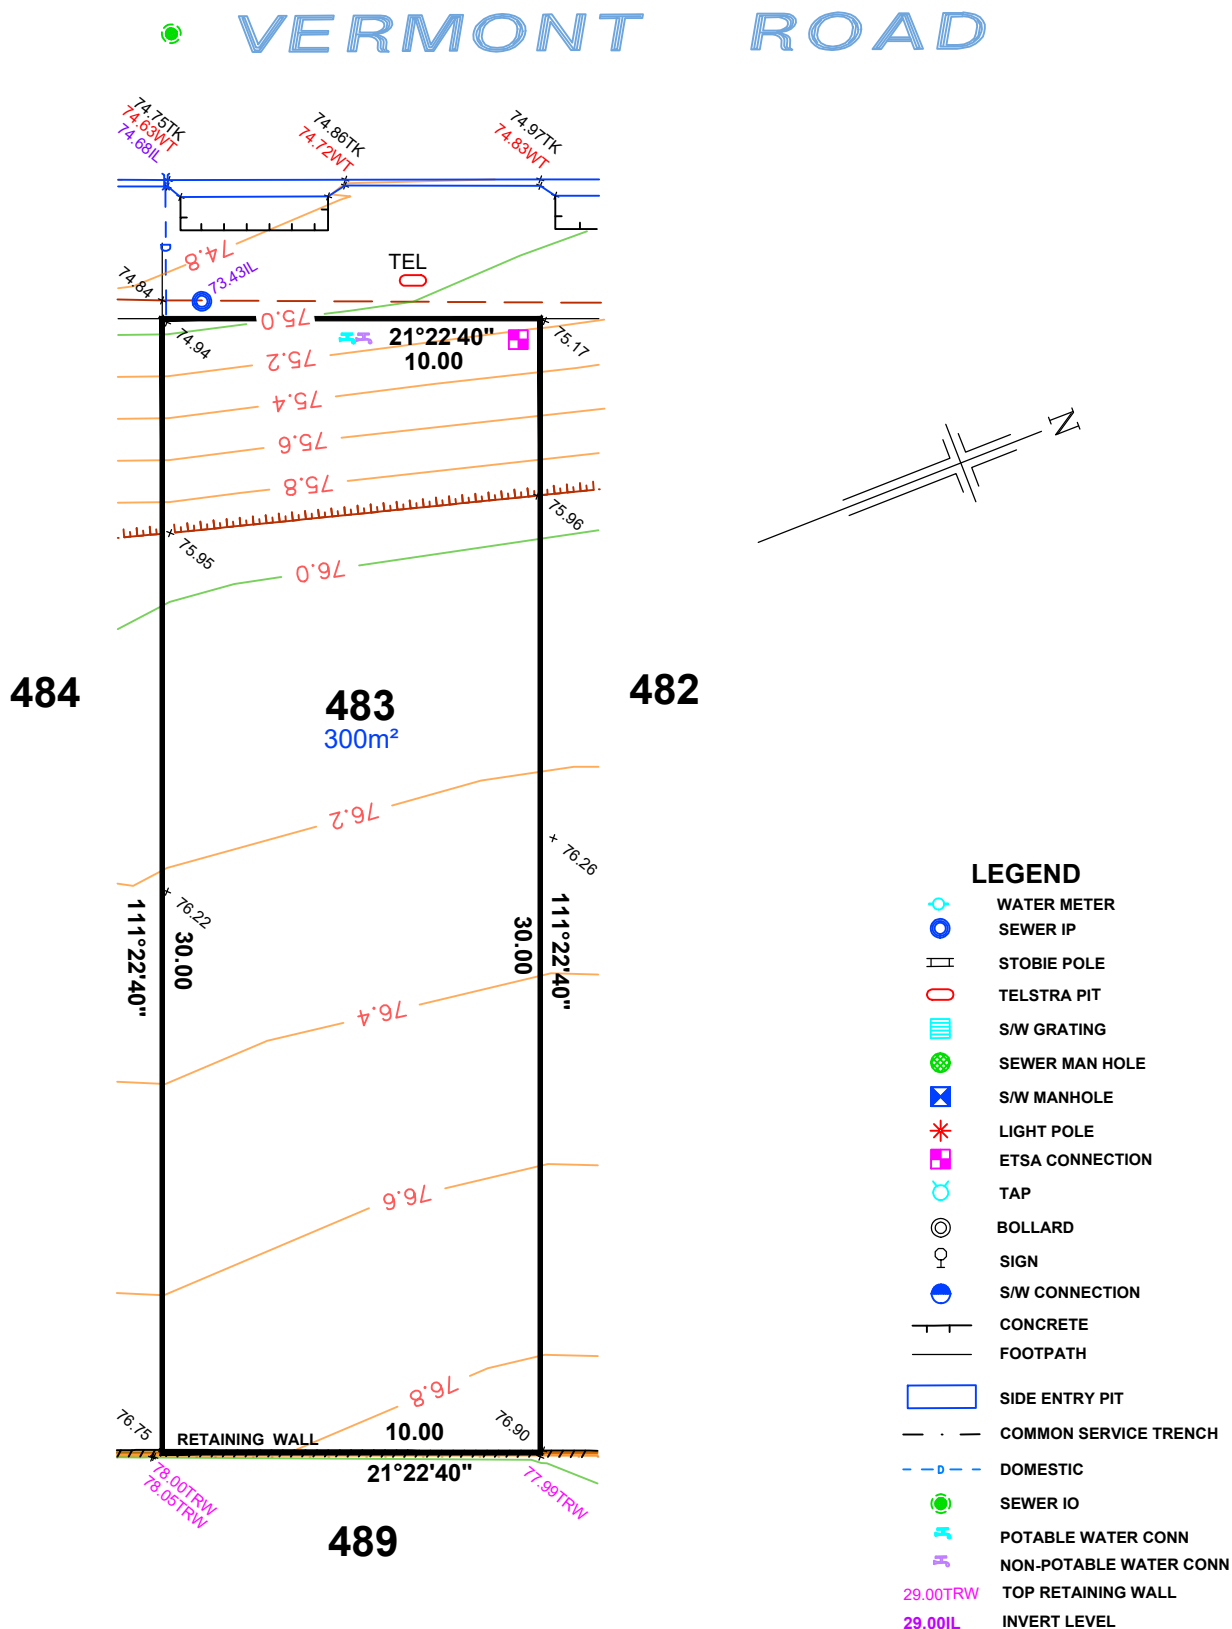

DISCLAIMER:

Please note that this site plan is intended for visual purposes only, additional survey work will be required prior to commencing any design or construction on the site.


ALLOTMENT 484 in DEV. NO. 145/D215/12/007

**in the area named
SEAFORD HEIGHTS**

CT ---/----


AS CONSTRUCTED

VERMONT ROAD

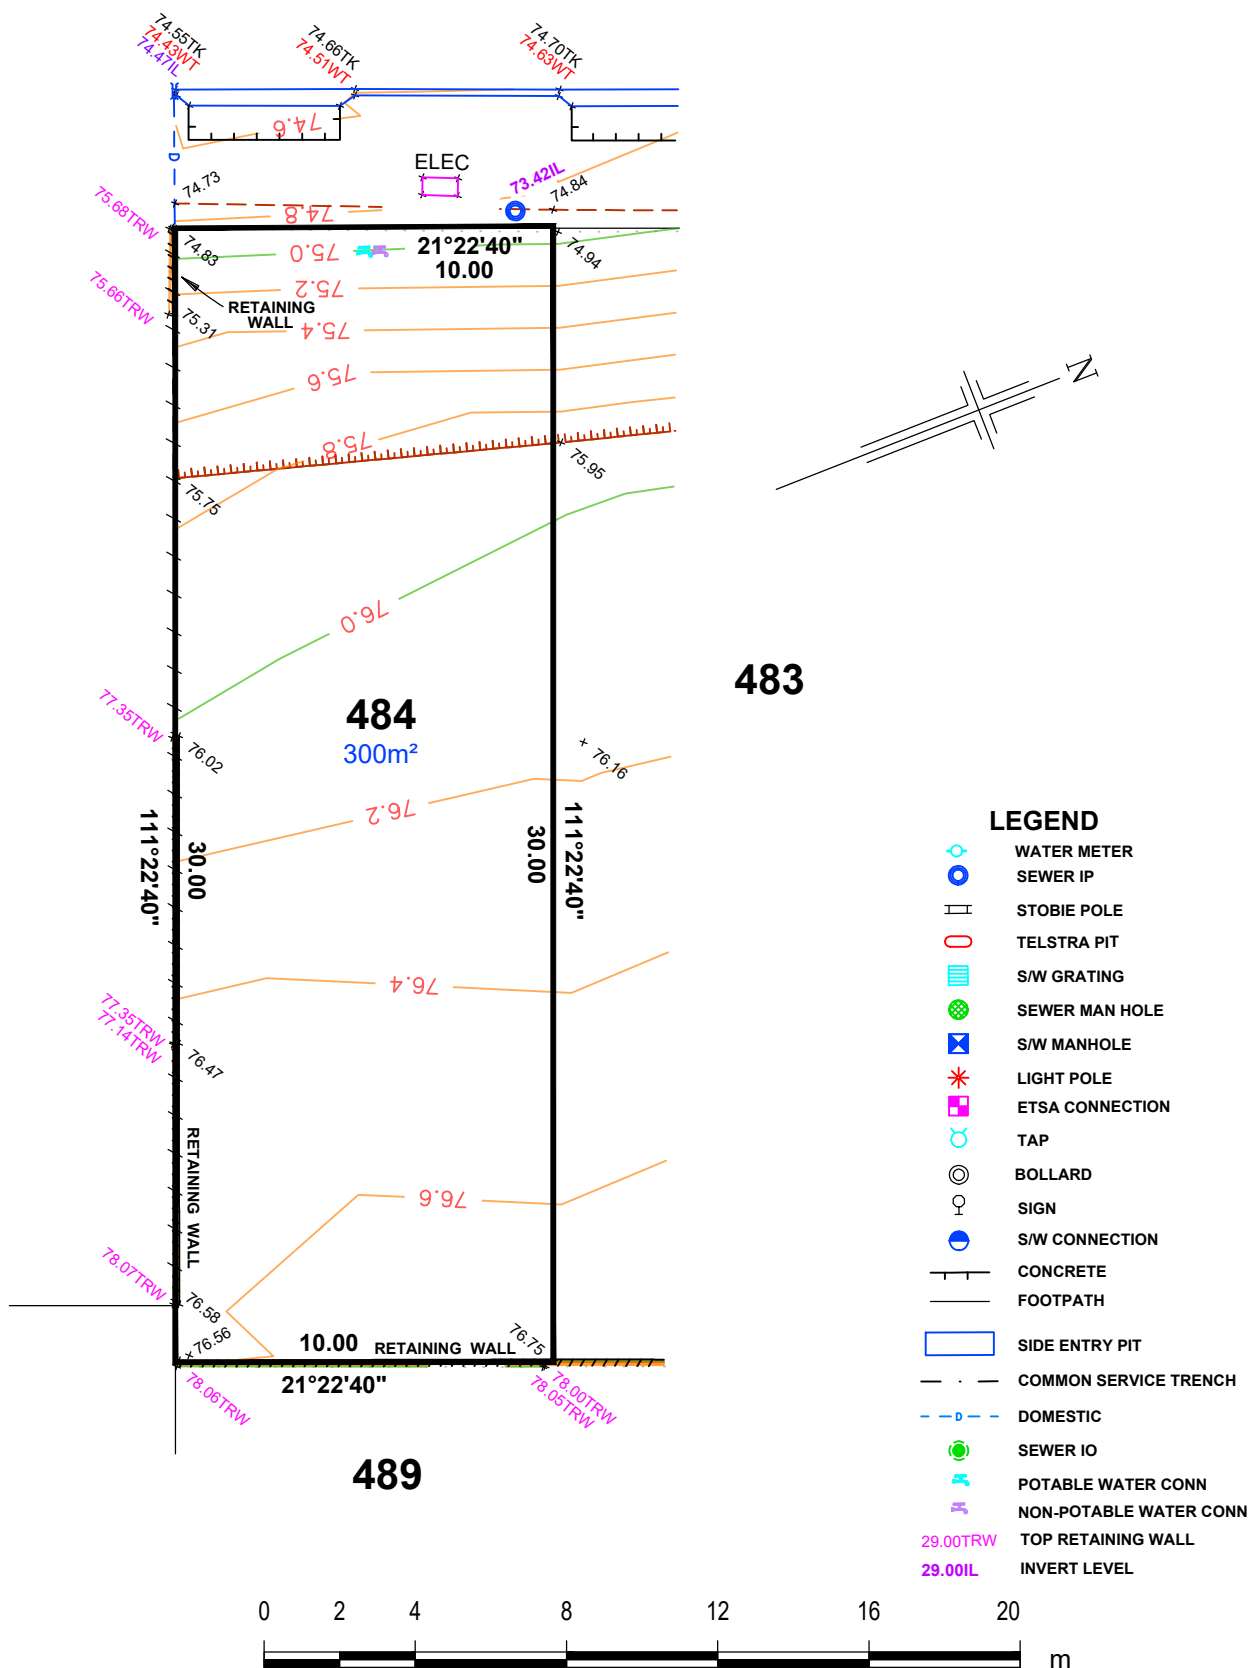

ALLOTMENT 489 in DEV. NO. 145/D215/12/008
in the area named
SEAFORD HEIGHTS
CT ---/----

AS CONSTRUCTED

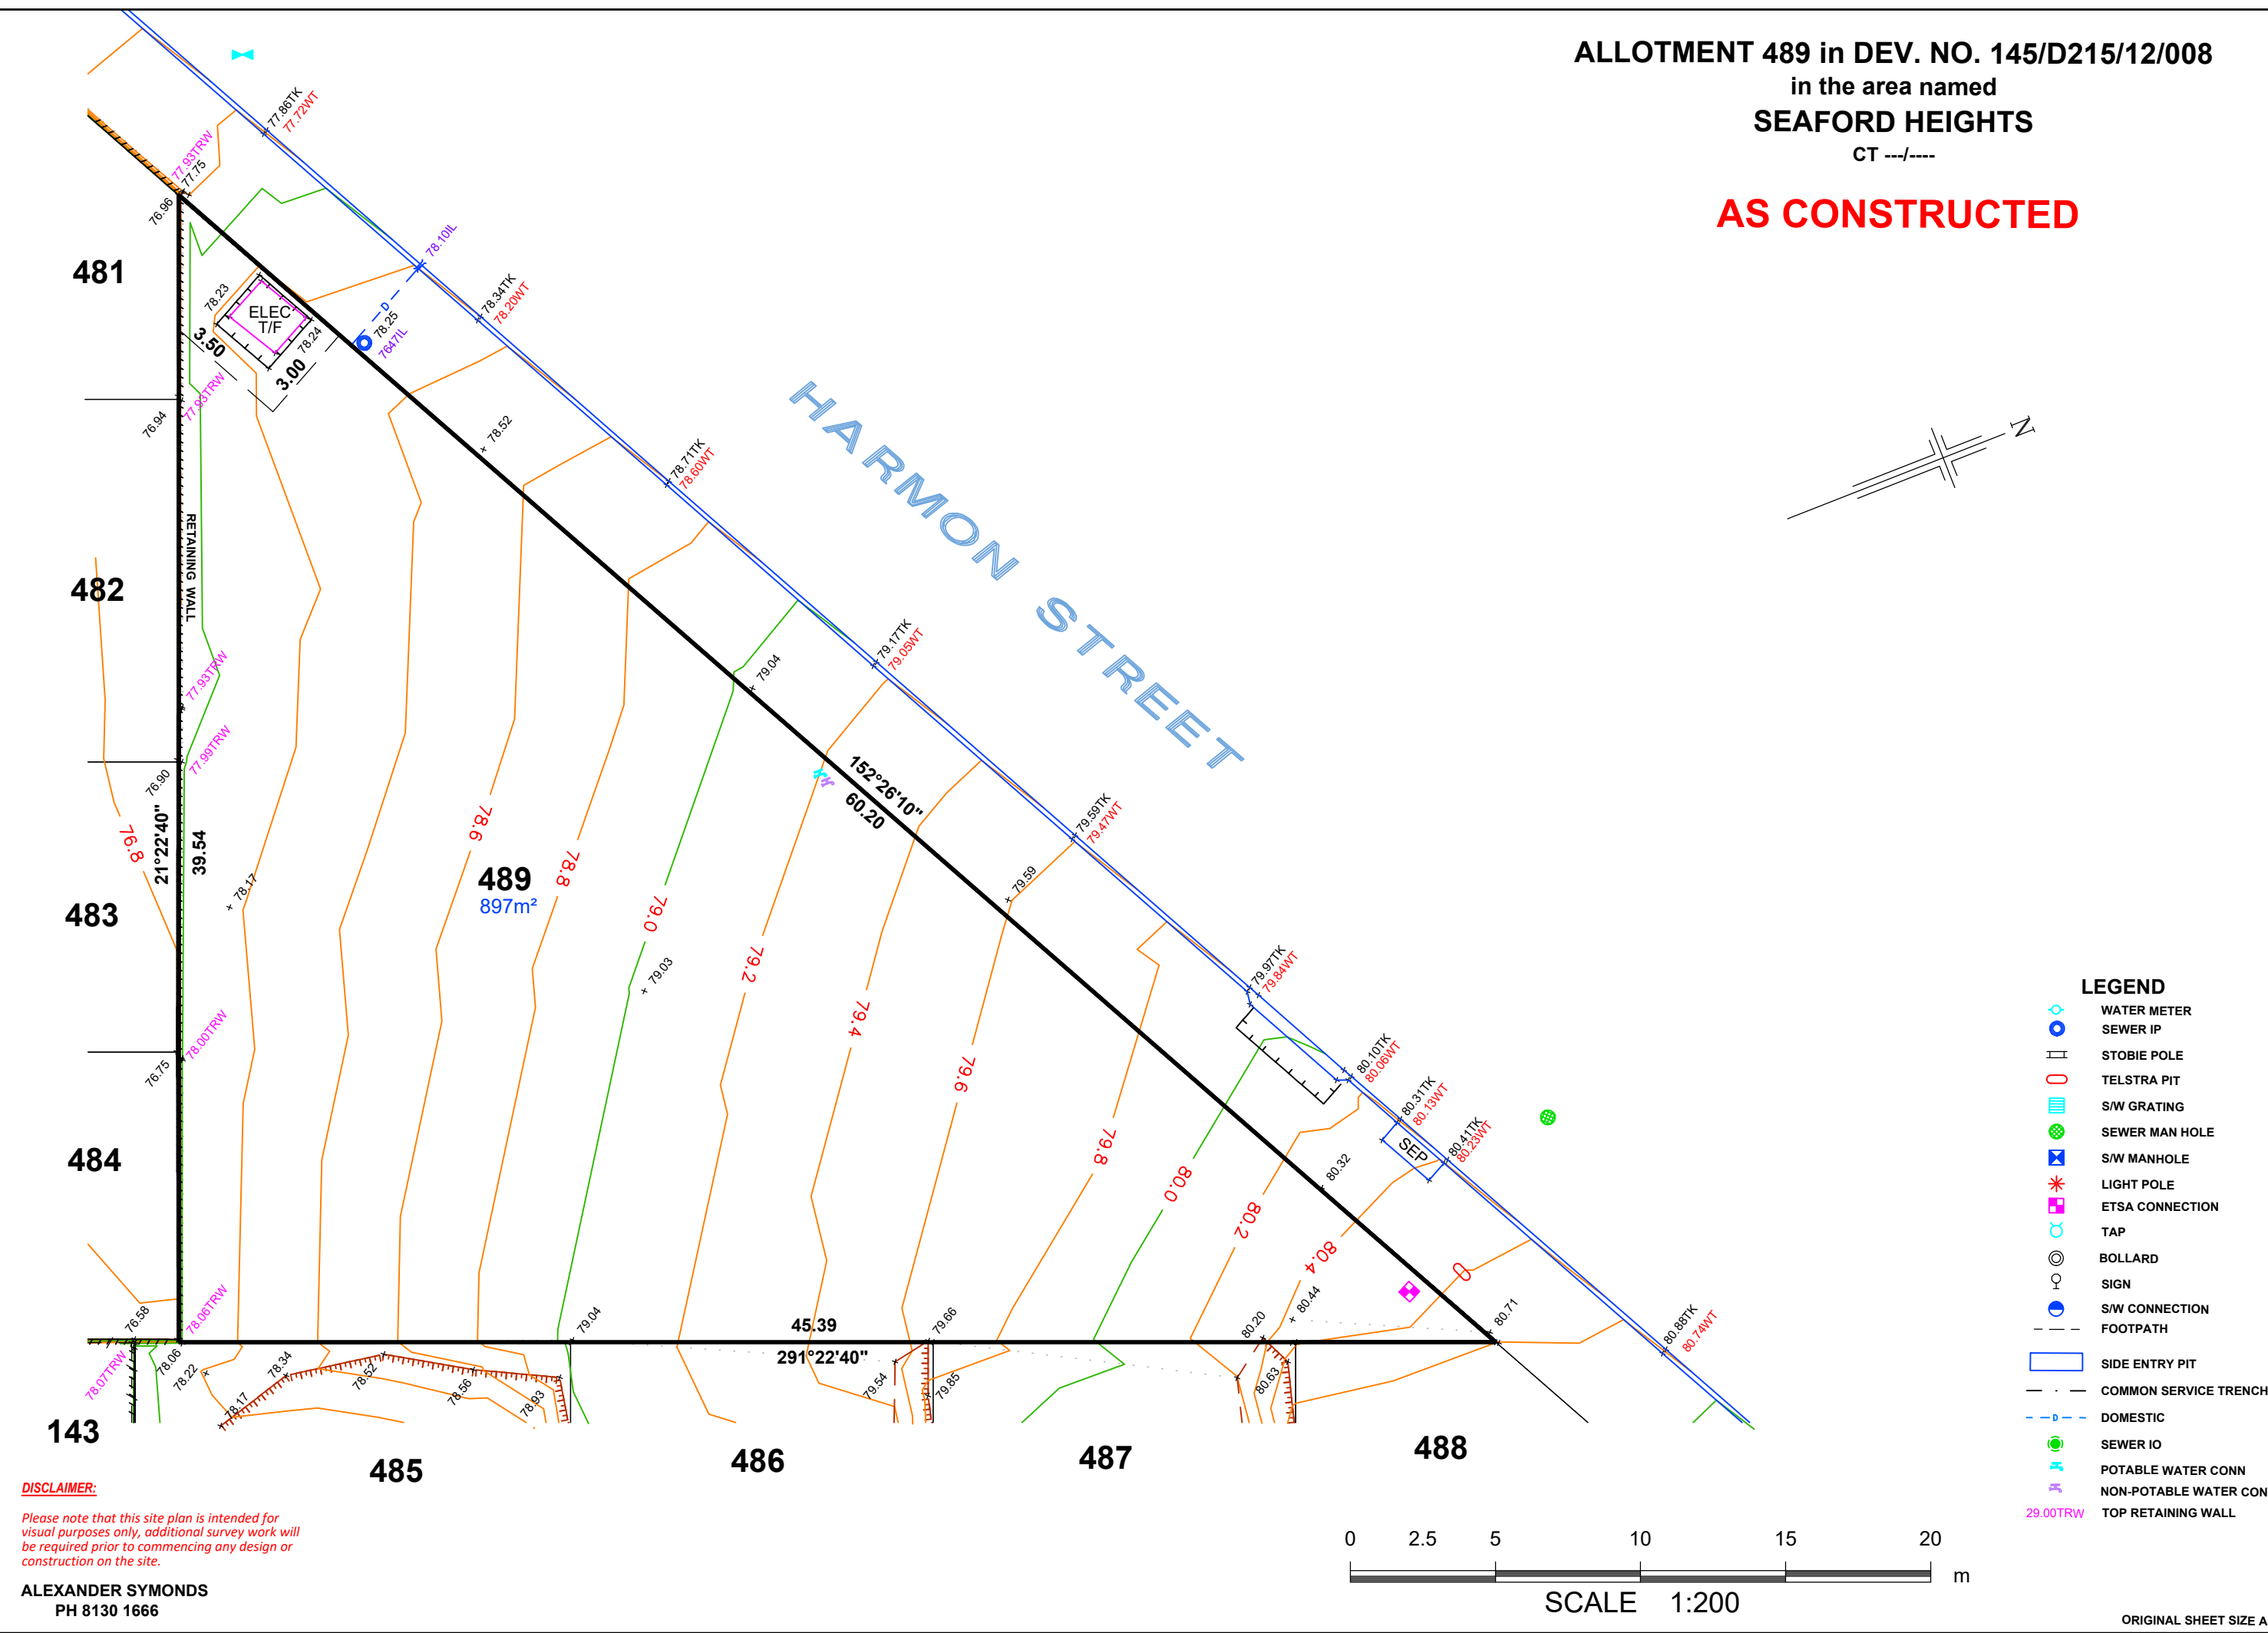


DISCLAIMER:

Please note that this site plan is intended for visual purposes only, additional survey work will be required prior to commencing any design or construction on the site.


ALLOTMENT 491 in DEV. NO. 145/D215/12/007
in the area named
SEAFORD HEIGHTS

CT ---/----

AS CONSTRUCTED

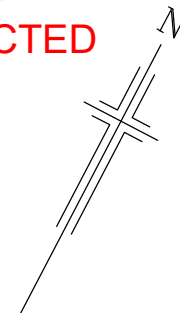

HARMON STREET

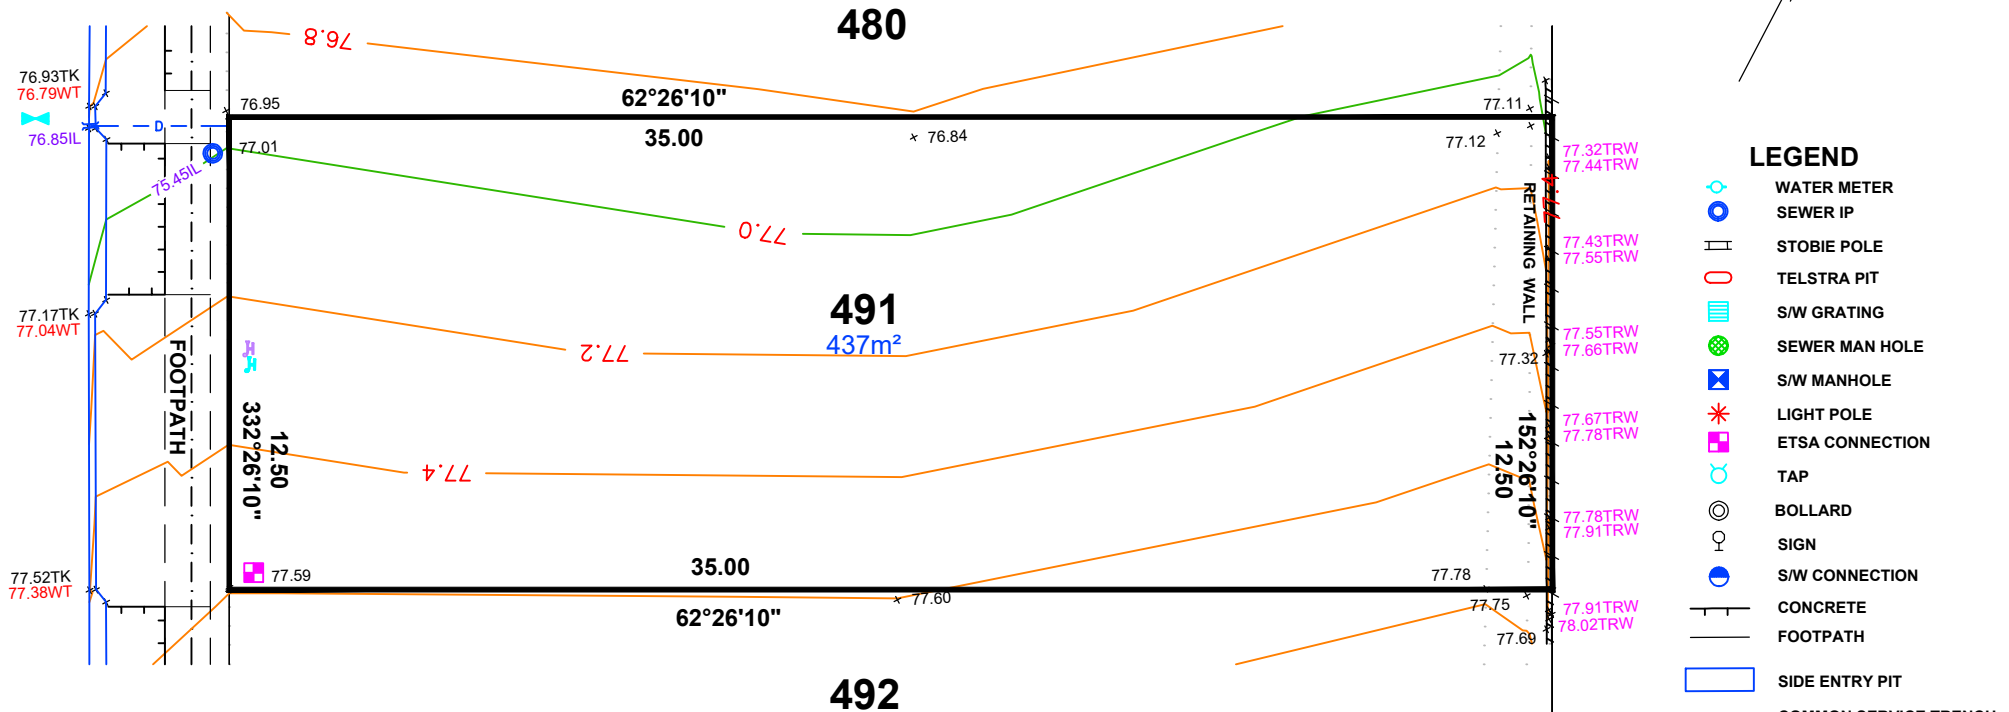

- LEGEND**
- WATER METER
 - SEWER IP
 - STOBIE POLE
 - TELSTRA PIT
 - S/W GRATING
 - SEWER MAN HOLE
 - S/W MANHOLE
 - LIGHT POLE
 - ETSA CONNECTION
 - TAP
 - BOLLARD
 - SIGN
 - S/W CONNECTION
 - CONCRETE
 - FOOTPATH
 - SIDE ENTRY PIT
 - COMMON SERVICE TRENCH
 - DOMESTIC
 - SEWER IO
 - POTABLE WATER CONN
 - NON-POTABLE WATER CONN
 - 29.00TRW TOP RETAINING WALL
 - 29.00IL INVERT LEVEL



1:200

NOTE: FOOTPATH & CST DATA SHOWN HEREON IS DESIGN INFORMATION AND SHOULD BE CONFIRMED



ORIGINAL SHEET SIZE A4

ALEXANDER SYMONDS
PH 8130 1666

Please note that this site plan is intended for visual purposes only, additional survey work will be required prior to commencing any design or construction on the site.

CT ---/---

AS CONSTRUCTED

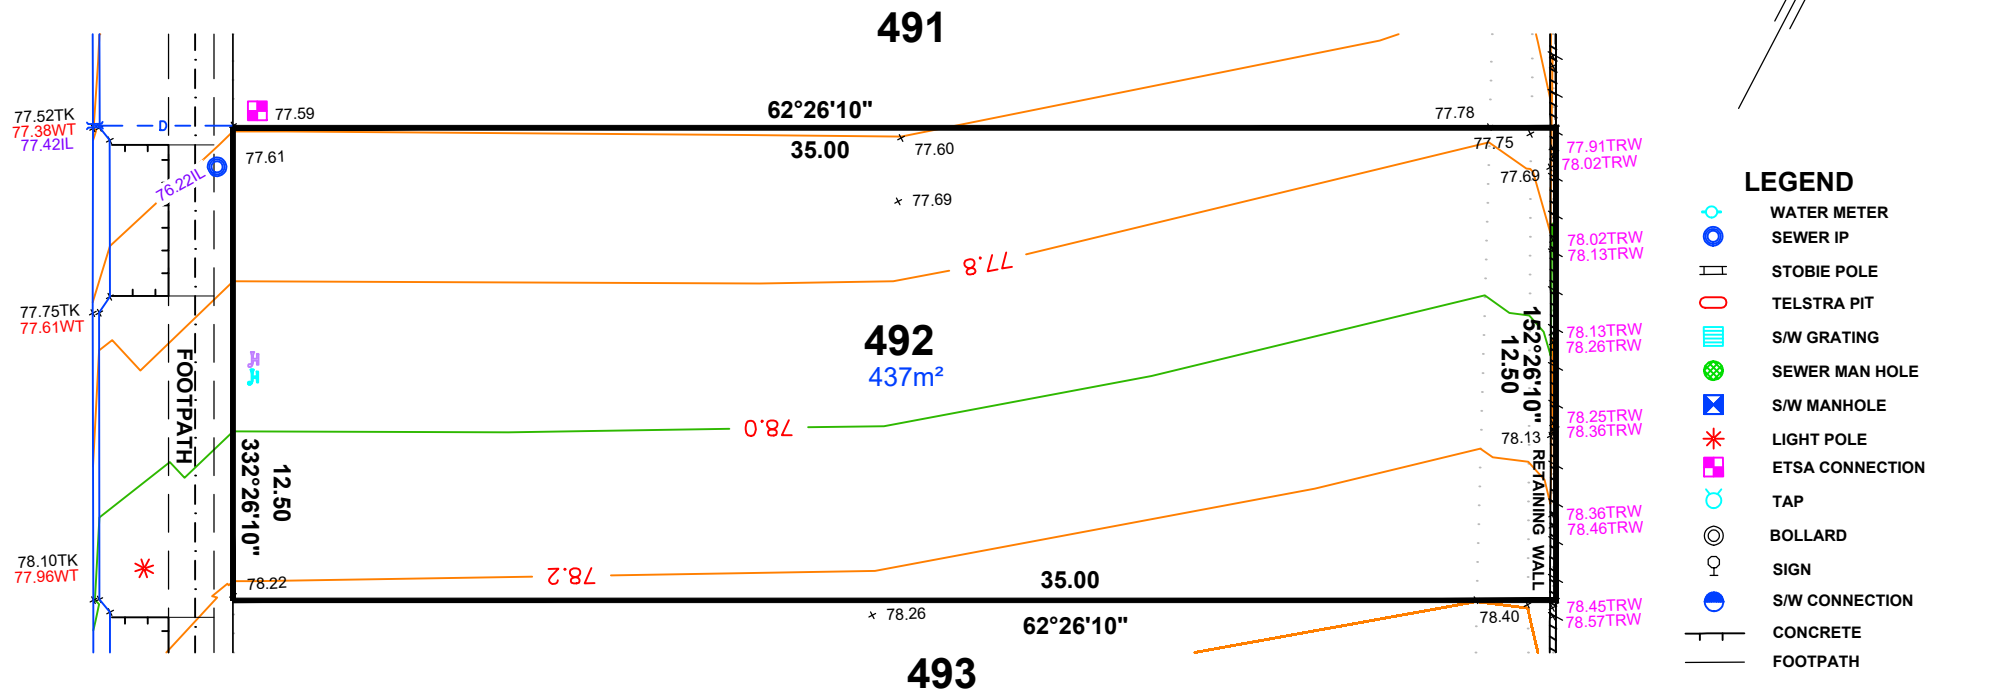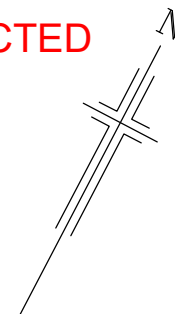

ALEXANDER SYMONDS
PH 8130 1666

1:200

NOTE: FOOTPATH & CST DATA SHOWN HEREON IS DESIGN INFORMATION AND SHOULD BE CONFIRMED


ORIGINAL SHEET SIZE A4

DISCLAIMER:


Please note that this site plan is intended for visual purposes only, additional survey work will be required prior to commencing any design or construction on the site.

ALLOTMENT 493 in DEV. NO. 145/D215/12/007
in the area named
SEAFORD HEIGHTS

CT ---/----
AS CONSTRUCTED

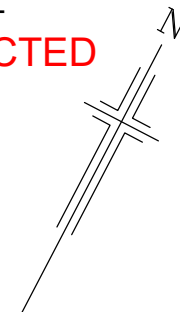

HARMON STREET

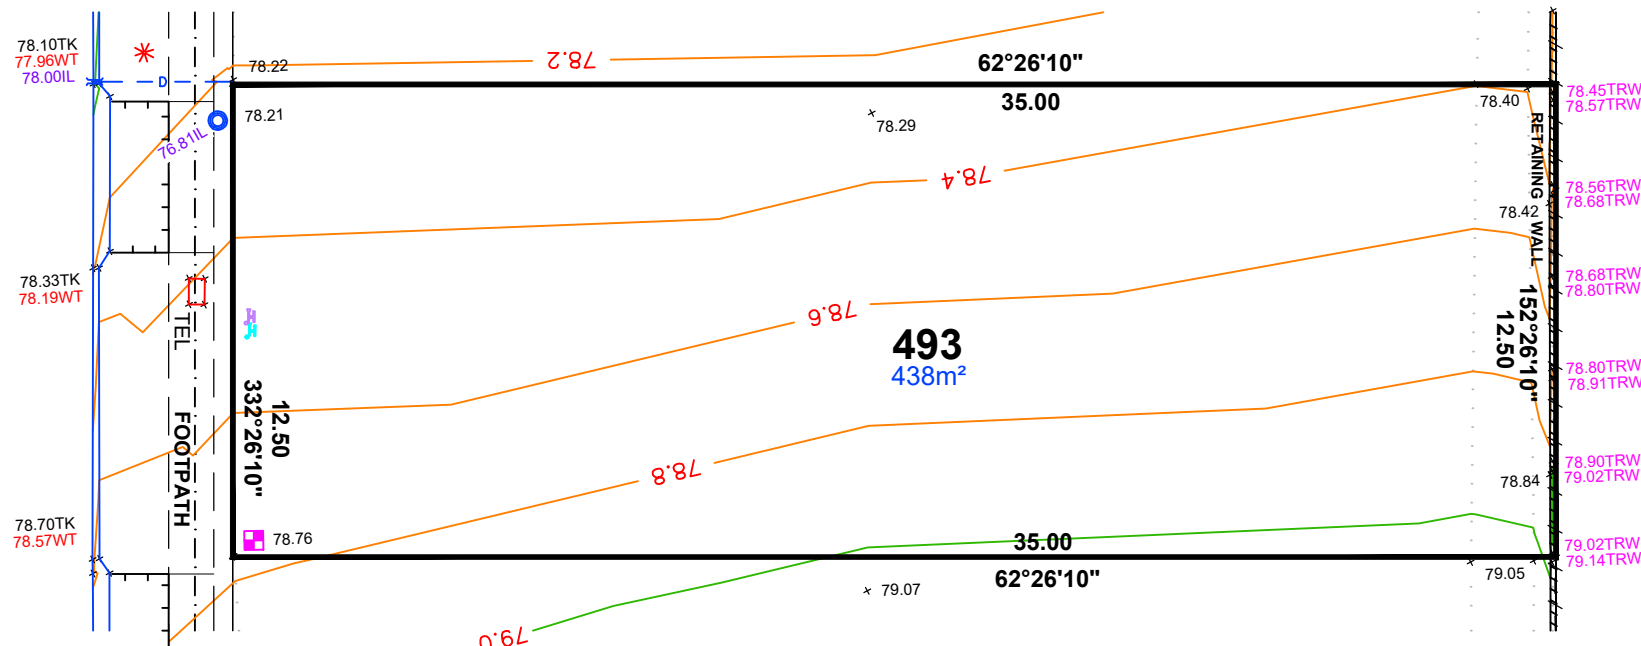

1:200

NOTE: FOOTPATH & CST DATA SHOWN HEREON IS DESIGN INFORMATION AND SHOULD BE CONFIRMED

ORIGINAL SHEET SIZE A4


ALEXANDER SYMONDS
PH 8130 1666

DISCLAIMER:


Please note that this site plan is intended for visual purposes only, additional survey work will be required prior to commencing any design or construction on the site.

ALLOTMENT 495 in DEV. NO. 145/D215/12/007
in the area named
SEAFORD HEIGHTS

CT ---/----
AS CONSTRUCTED

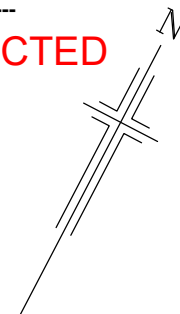

HARMON STREET

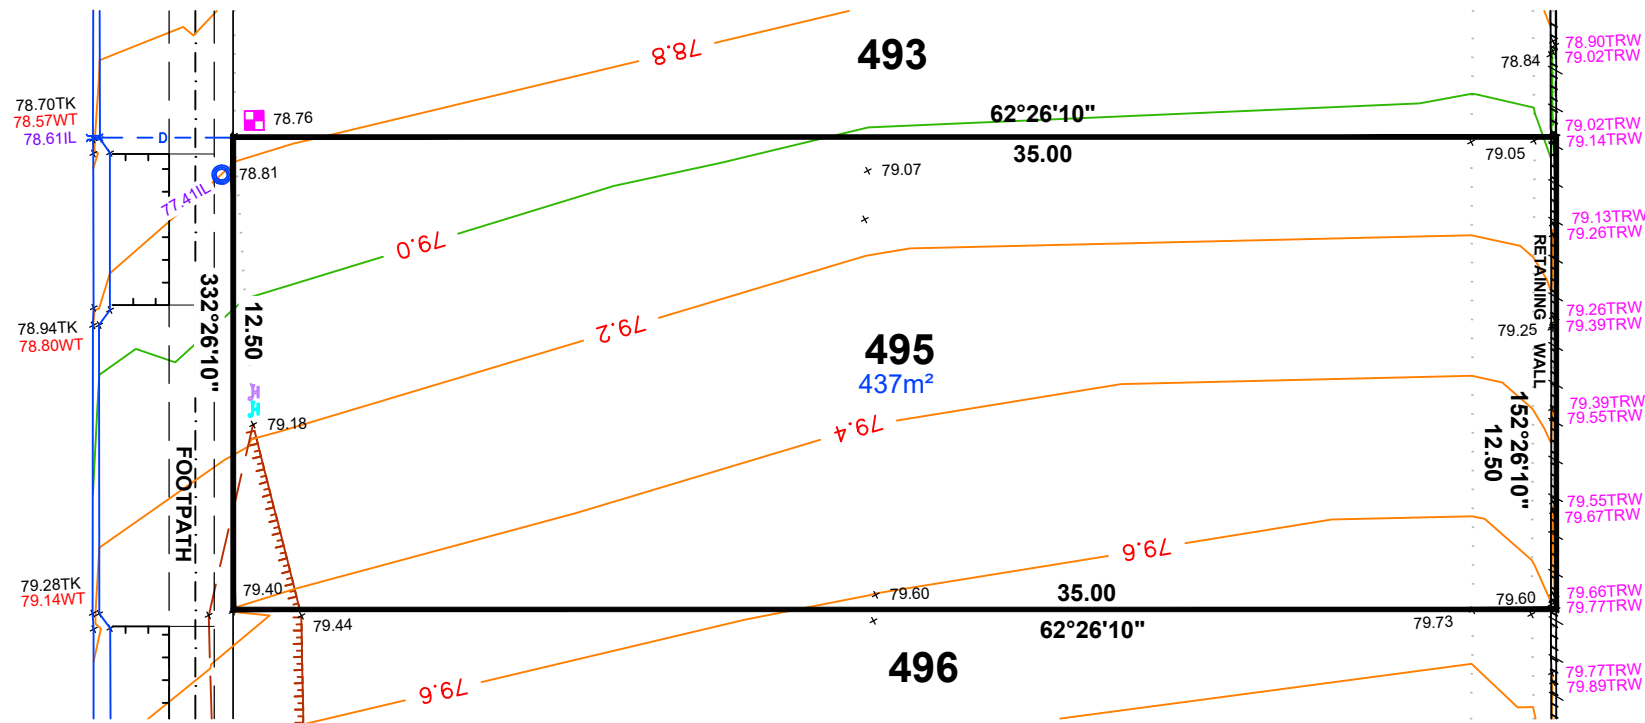

LEGEND

- WATER METER
- SEWER IP
- STOBIE POLE
- TELSTRA PIT
- S/W GRATING
- SEWER MAN HOLE
- S/W MANHOLE
- LIGHT POLE
- ETSA CONNECTION
- TAP
- BOLLARD
- SIGN
- S/W CONNECTION
- CONCRETE
- FOOTPATH
- SIDE ENTRY PIT
- COMMON SERVICE TRENCH
- DOMESTIC
- SEWER IO
- POTABLE WATER CONN
- NON-POTABLE WATER CONN
- TOP RETAINING WALL
- INVERT LEVEL



ALEXANDER SYMONDS
PH 8130 1666

1:200

NOTE: FOOTPATH & CST DATA SHOWN HEREON IS DESIGN INFORMATION AND SHOULD BE CONFIRMED


ORIGINAL SHEET SIZE A4

DISCLAIMER:


Please note that this site plan is intended for visual purposes only, additional survey work will be required prior to commencing any design or construction on the site.

ALLOTMENT 496 in DEV. NO. 145/D215/12/007
in the area named
SEAFORD HEIGHTS

CT ---/----
AS CONSTRUCTED

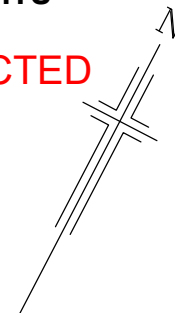

HARMON STREET

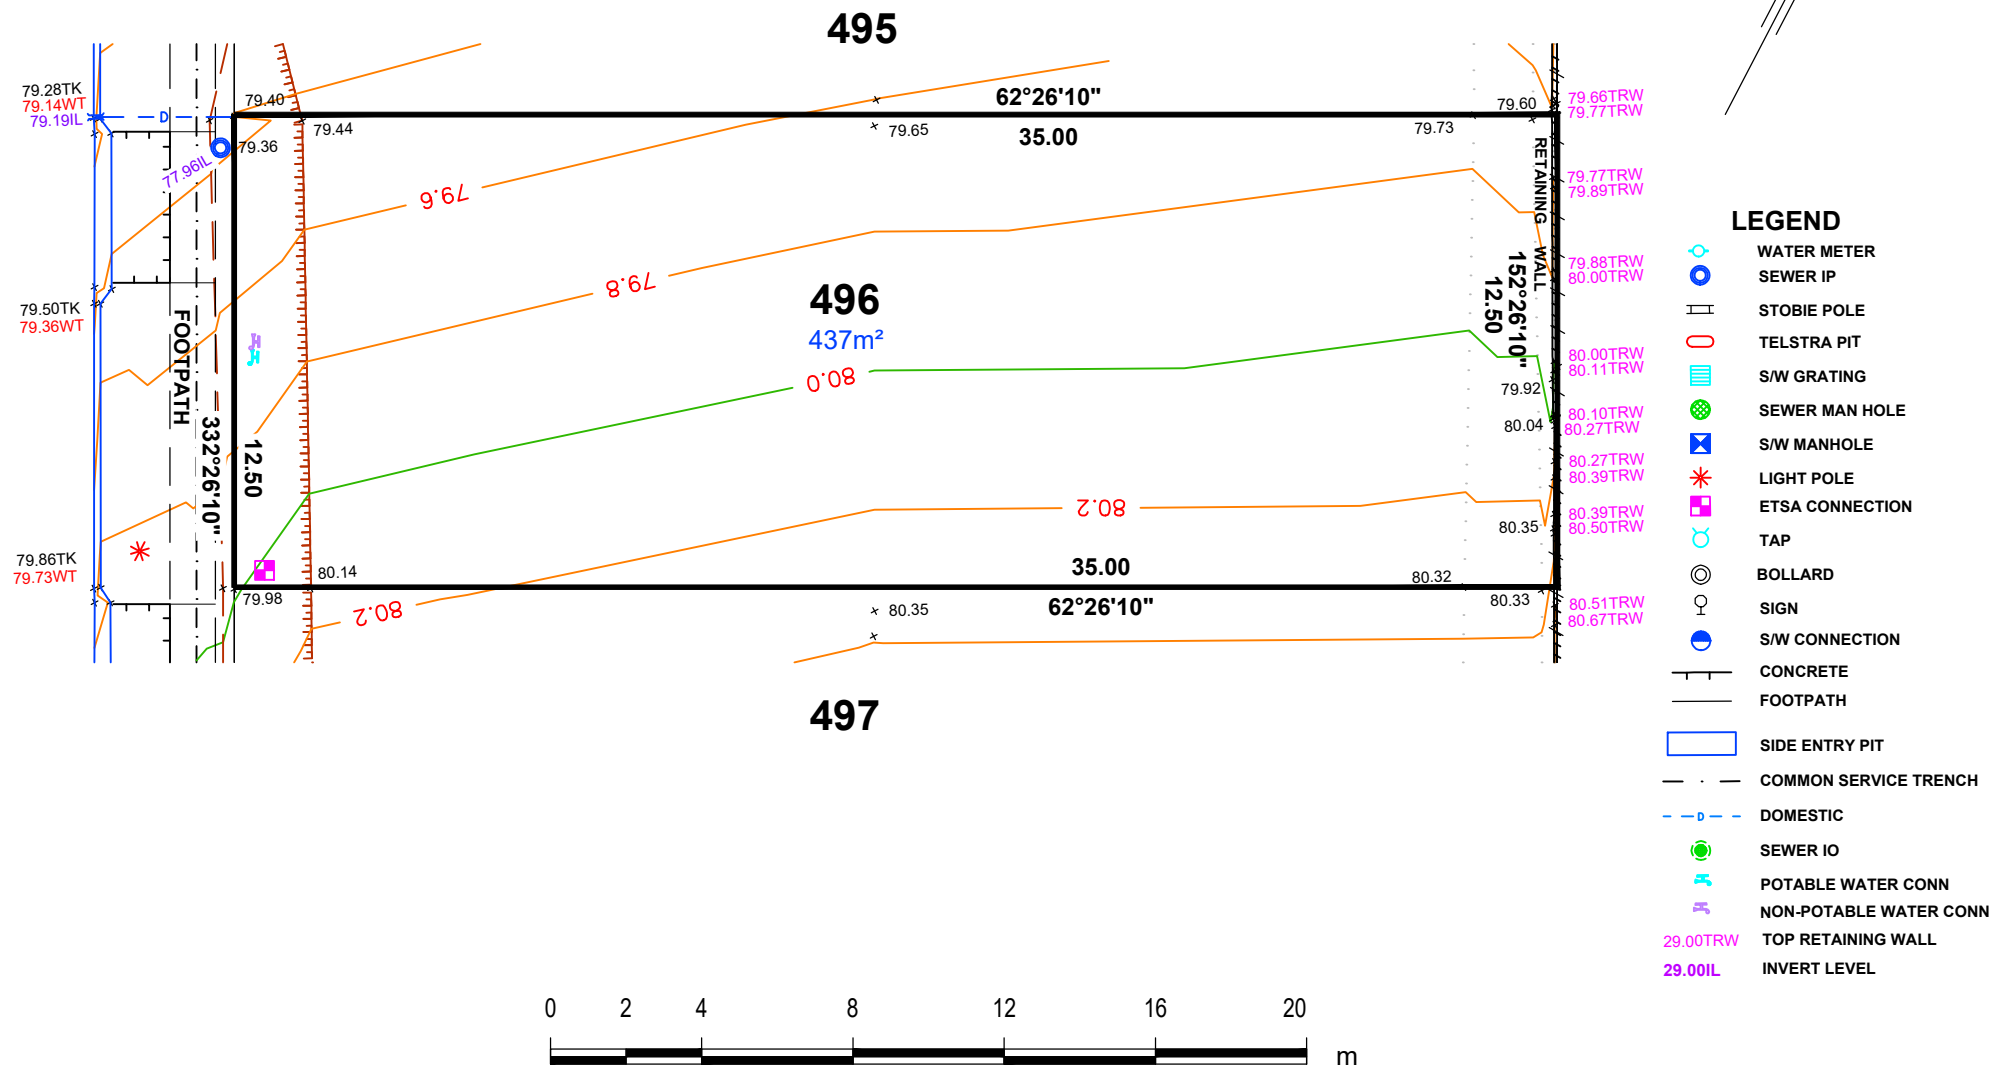

ALEXANDER SYMONDS
PH 8130 1666


NOTE: FOOTPATH & CST DATA SHOWN HEREON IS DESIGN INFORMATION AND SHOULD BE CONFIRMED
ORIGINAL SHEET SIZE A4

DISCLAIMER:


Please note that this site plan is intended for visual purposes only, additional survey work will be required prior to commencing any design or construction on the site.

ALLOTMENT 497 in DEV. NO. 145/D215/12/007
in the area named
SEAFORD HEIGHTS

CT ---/----
AS CONSTRUCTED

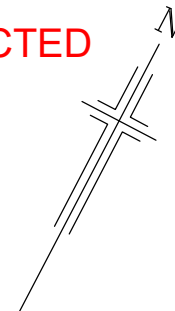

HARMON STREET

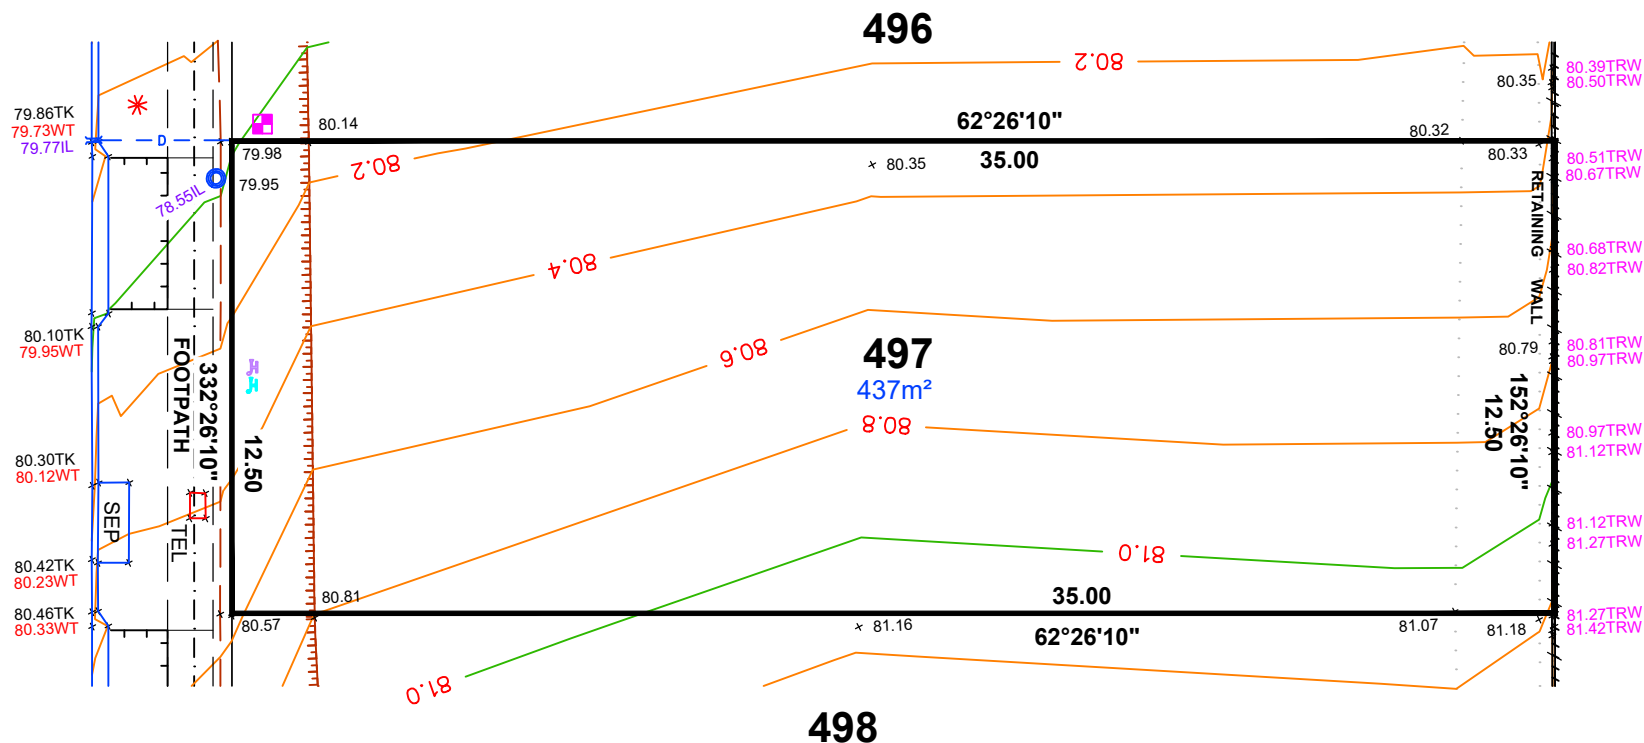

LEGEND

- WATER METER
- SEWER IP
- STOBIE POLE
- TELSTRA PIT
- S/W GRATING
- SEWER MAN HOLE
- S/W MANHOLE
- LIGHT POLE
- ETSA CONNECTION
- TAP
- BOLLARD
- SIGN
- S/W CONNECTION
- CONCRETE
- FOOTPATH
- SIDE ENTRY PIT
- COMMON SERVICE TRENCH
- DOMESTIC
- SEWER IO
- POTABLE WATER CONN
- NON-POTABLE WATER CONN
- TOP RETAINING WALL
- INVERT LEVEL



1:200

NOTE: FOOTPATH & CST DATA SHOWN HEREON IS DESIGN INFORMATION AND SHOULD BE CONFIRMED

ORIGINAL SHEET SIZE A4


ALEXANDER SYMONDS
PH 8130 1666

DISCLAIMER:


Please note that this site plan is intended for visual purposes only, additional survey work will be required prior to commencing any design or construction on the site.

ALLOTMENT 498 in DEV. NO. 145/D215/12/007
in the area named
SEAFORD HEIGHTS

CT ---/---
AS CONSTRUCTED

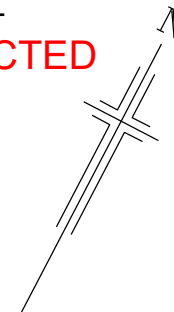

HARMON STREET

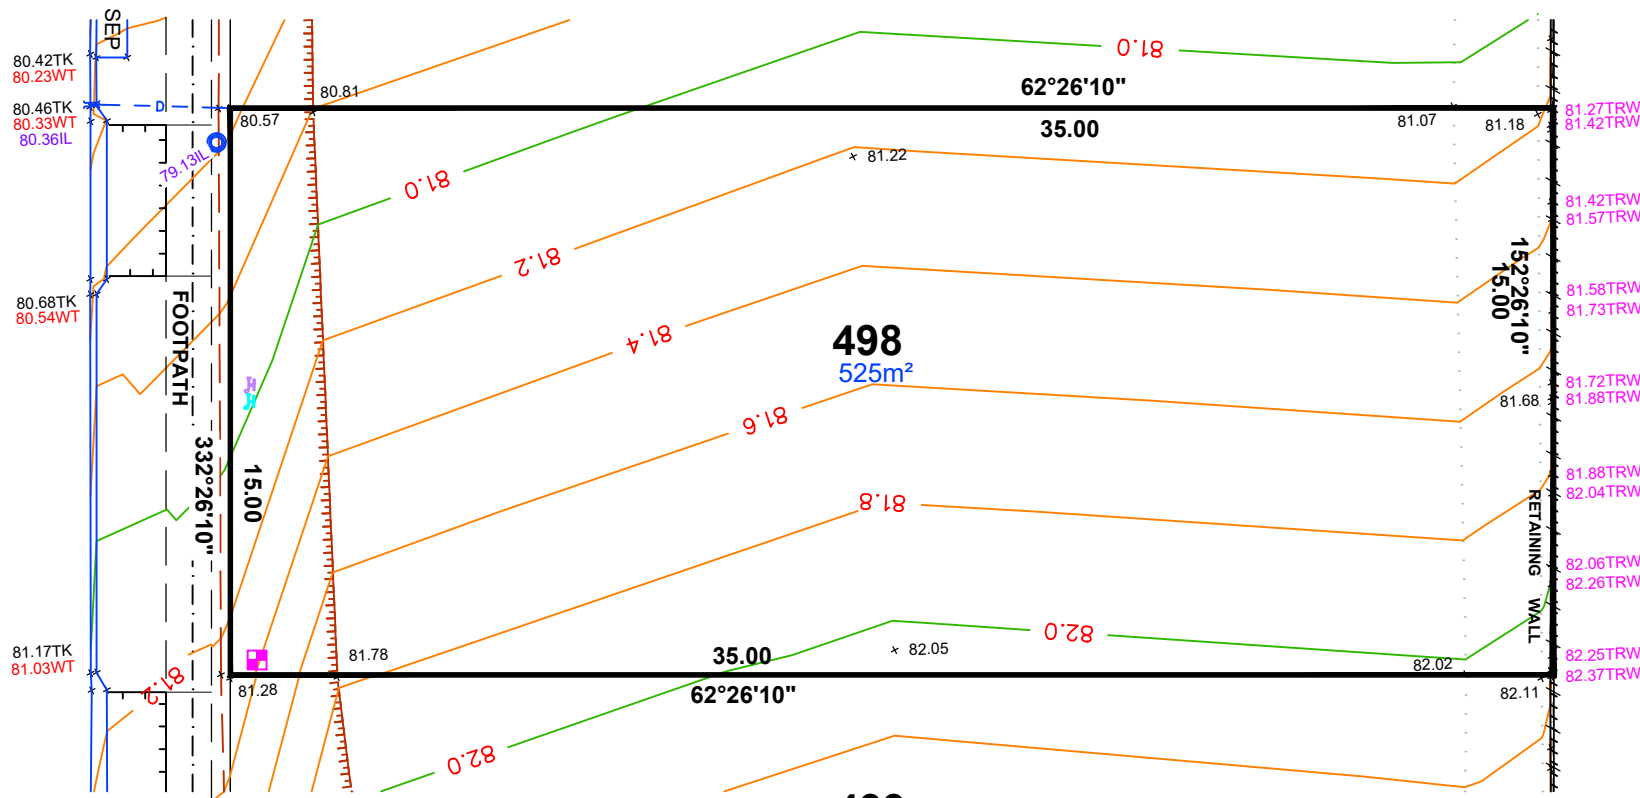

LEGEND

- WATER METER
- SEWER IP
- STOBIE POLE
- TELSTRA PIT
- S/W GRATING
- SEWER MAN HOLE
- S/W MANHOLE
- LIGHT POLE
- ETSA CONNECTION
- TAP
- BOLLARD
- SIGN
- S/W CONNECTION
- CONCRETE
- FOOTPATH
- SIDE ENTRY PIT
- COMMON SERVICE TRENCH
- DOMESTIC
- SEWER IO
- POTABLE WATER CONN
- NON-POTABLE WATER CONN
- TOP RETAINING WALL
- INVERT LEVEL



1:200

ALEXANDER SYMONDS
PH 8130 1666

NOTE: FOOTPATH & CST DATA SHOWN HEREON IS DESIGN INFORMATION AND SHOULD BE CONFIRMED


ORIGINAL SHEET SIZE A4

DISCLAIMER:

Please note that this site plan is intended for visual purposes only, additional survey work will be required prior to commencing any design or construction on the site.

ALLOTMENT 499 in DEV. NO. 145/D215/12/007
in the area named
SEAFORD HEIGHTS

CT ---/----
AS CONSTRUCTED

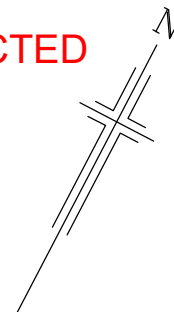

498

499
525m²

500

HARMON STREET

LEGEND

- WATER METER
- SEWER IP
- STOBIE POLE
- TELSTRA PIT
- S/W GRATING
- SEWER MAN HOLE
- S/W MANHOLE
- LIGHT POLE
- ETSA CONNECTION
- TAP
- BOLLARD
- SIGN
- S/W CONNECTION
- CONCRETE
- FOOTPATH
- SIDE ENTRY PIT
- COMMON SERVICE TRENCH
- DOMESTIC
- SEWER IO
- POTABLE WATER CONN
- NON-POTABLE WATER CONN
- TOP RETAINING WALL
- INVERT LEVEL



1:200

NOTE: FOOTPATH & CST DATA SHOWN HEREON IS DESIGN INFORMATION AND SHOULD BE CONFIRMED



ORIGINAL SHEET SIZE A4

ALEXANDER SYMONDS
PH 8130 1666

DISCLAIMER:
Please note that this site plan is intended for visual purposes only, additional survey work will be required prior to commencing any design or construction on the site.

ALLOTMENT 500 in DEV. NO. 145/D215/12/007
in the area named
SEAFORD HEIGHTS
CT ---/----


AS CONSTRUCTED

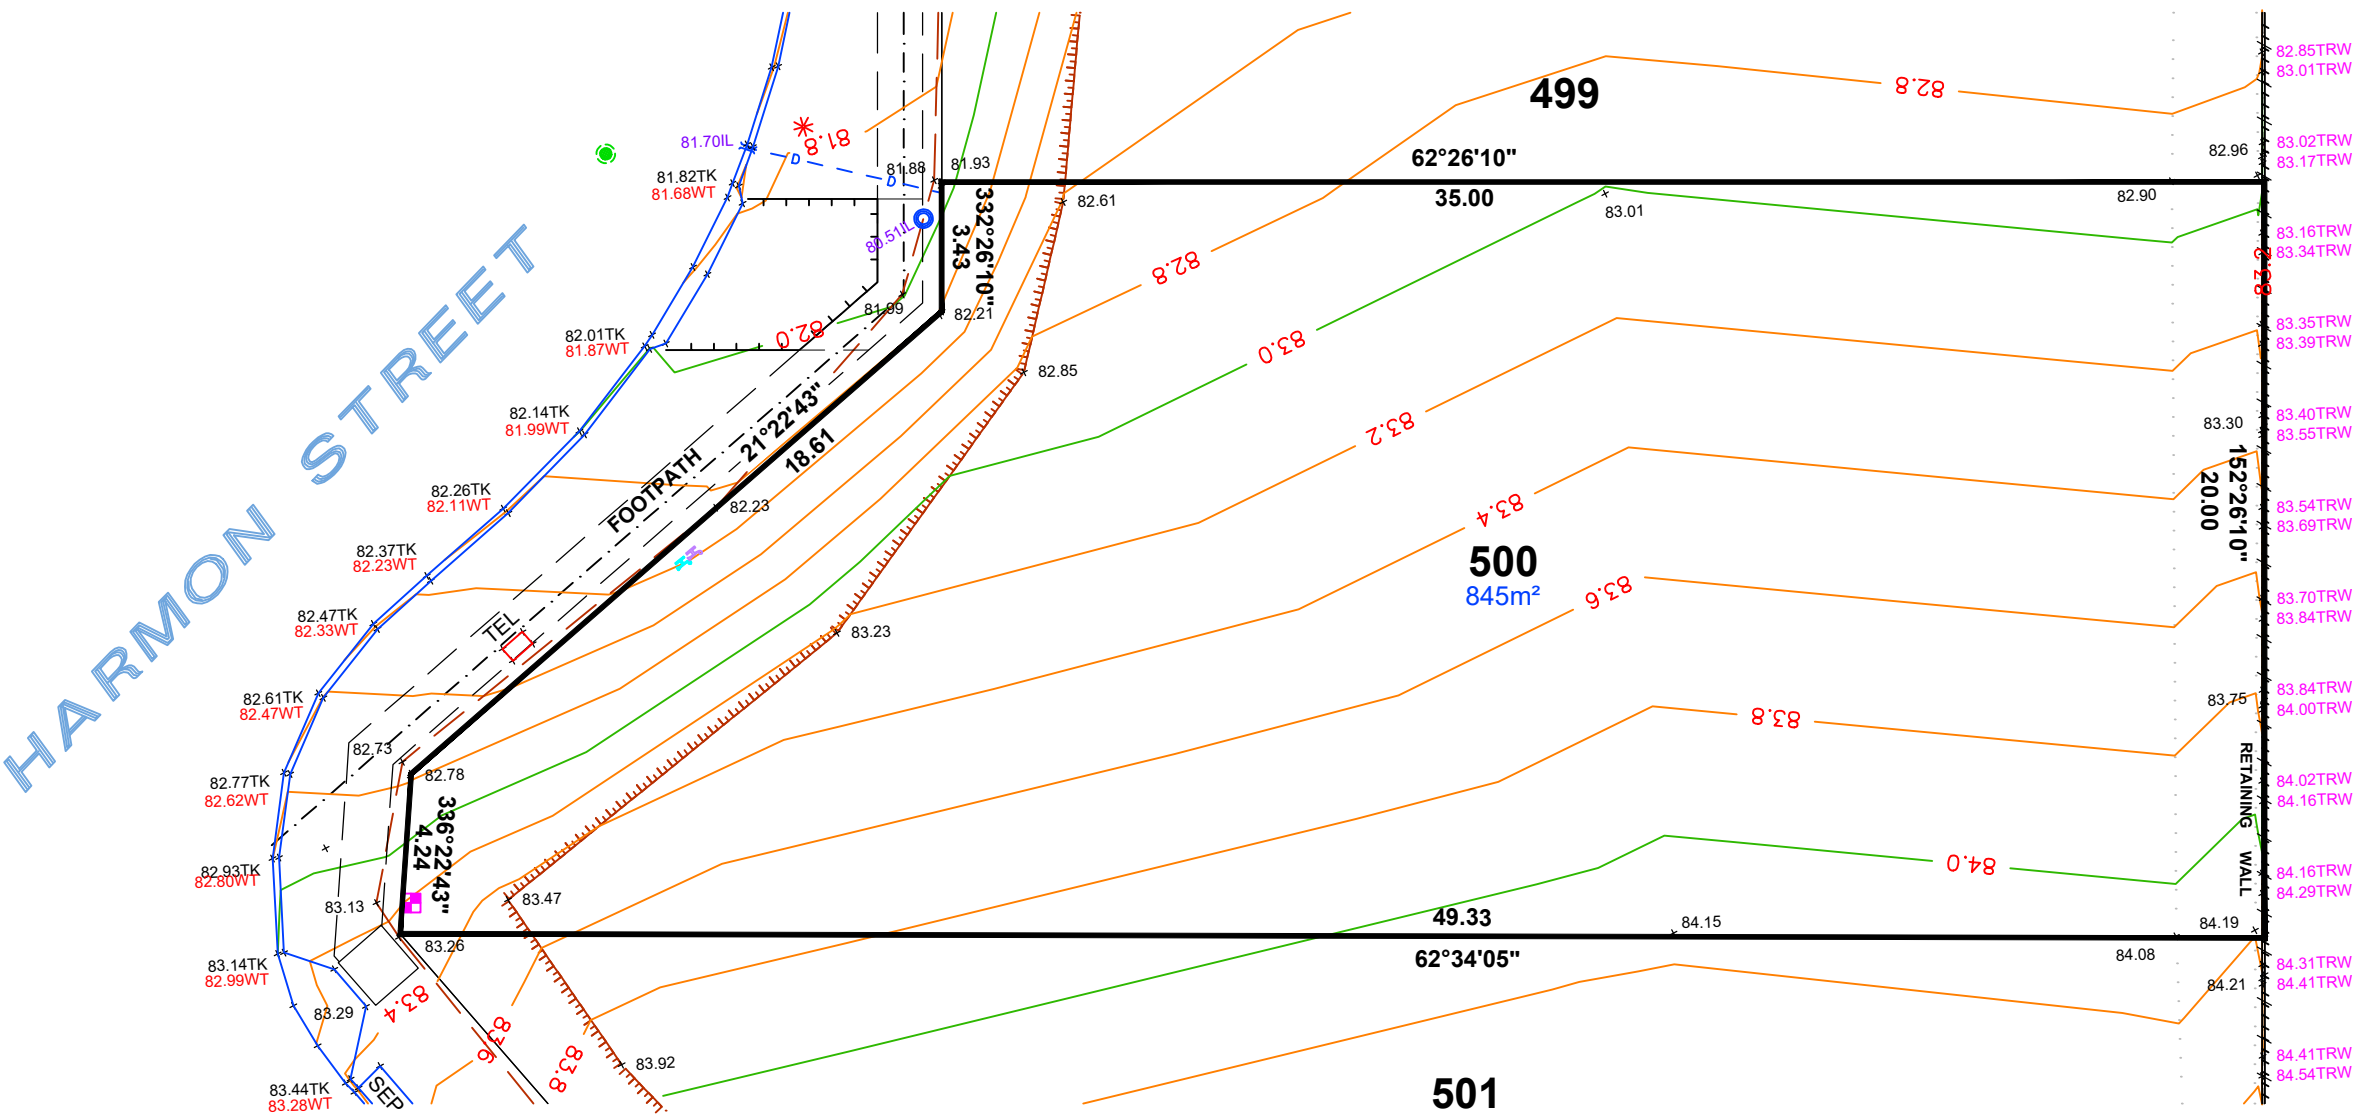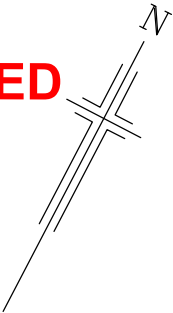

- LEGEND**
- WATER METER
 - SEWER IP
 - STOBIE POLE
 - TELSTRA PIT
 - S/W GRATING
 - SEWER MAN HOLE
 - S/W MANHOLE
 - LIGHT POLE
 - ETSA CONNECTION
 - TAP
 - BOLLARD
 - SIGN
 - S/W CONNECTION
 - CONCRETE
 - FOOTPATH
 - SIDE ENTRY PIT
 - COMMON SERVICE TRENCH
 - DOMESTIC
 - SEWER IO
 - POTABLE WATER CONN
 - NON-POTABLE WATER CONN
 - 29.00TRW
 - 29.00IL

NOTE: FOOTPATH & CST DATA SHOWN HEREON IS DESIGN INFORMATION AND SHOULD BE CONFIRMED.

ALEXANDER SYMONDS
PH 8130 1666


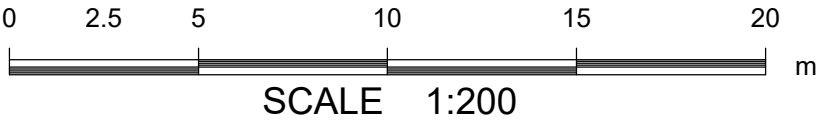


ORIGINAL SHEET SIZE A3

DISCLAIMER:
Please note that this site plan is intended for visual purposes only, additional survey work will be required prior to commencing any design or construction on the site.

ALLOTMENT 501 in DEV. NO. 145/D215/12/007
in the area named
SEAFORD HEIGHTS
CT ---/----

AS CONSTRUCTED

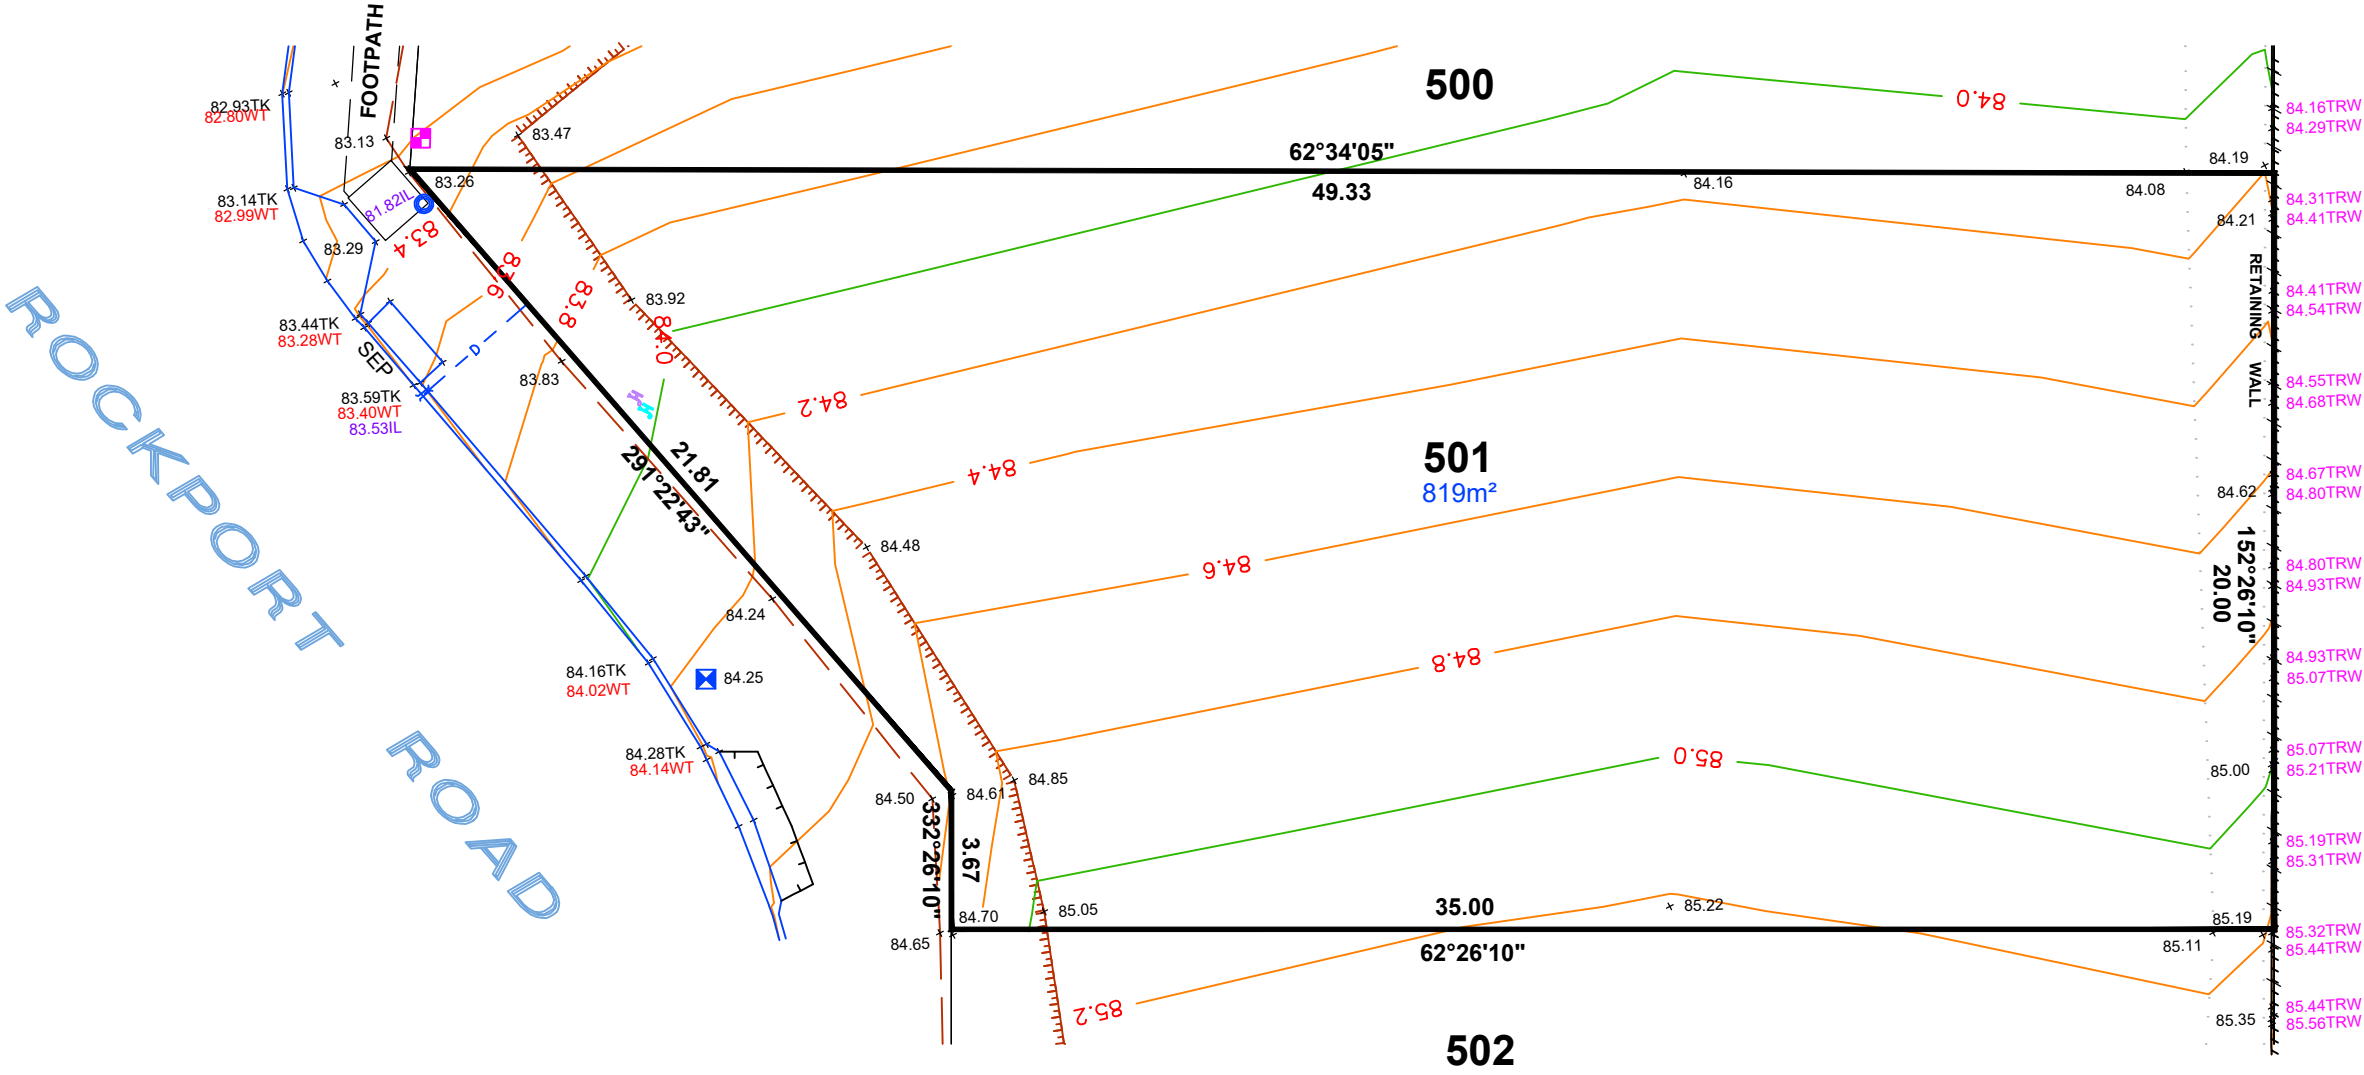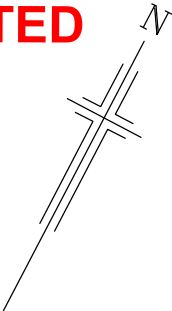

- LEGEND**
- WATER METER
 - SEWER IP
 - STOBIE POLE
 - TELSTRA PIT
 - S/W GRATING
 - SEWER MAN HOLE
 - S/W MANHOLE
 - LIGHT POLE
 - ETSA CONNECTION
 - TAP
 - BOLLARD
 - SIGN
 - S/W CONNECTION
 - CONCRETE
 - FOOTPATH
 - SIDE ENTRY PIT
 - COMMON SERVICE TRENCH
 - DOMESTIC
 - SEWER IO
 - POTABLE WATER CONN
 - NON-POTABLE WATER CONN
 - 29.00TRW TOP RETAINING WALL
 - 29.00IL INVERT LEVEL

NOTE: FOOTPATH & CST DATA SHOWN HEREON IS DESIGN INFORMATION AND SHOULD BE CONFIRMED.
ALEXANDER SYMONDS
PH 8130 1666

